

Dodd M. Kattman AIA, LEED AP, Principal Jerome T. Nix AIA, Principal Zachary R. Benedict AIA, LEED AP, Principal Matthew D. Sparling AIA, LEED AP, Principal Andrew J. Mitchell AIA, ACHA, Associate Principal

PROJECT:	Wells County Public Library Renovations	SUPPLEMENTAL INFORMATION (SI) NU	JMBER: 55R1
	Renovations	DATE OF ISSUE:	7/7/2020
OWNER:	WCPL	CONTRACT FOR:	General Construction
		CONTRACT DATED:	12/9/2019
TO CONTRACTOR:	CME Corporation	ARCHITECT'S PROJECT NUMBER:	19067
Submit proposal or p	proceed with the Work as indicated I	below:	
Contract Time fo	r proposed modifications to the Contrac	T: Please submit an itemized proposal for changes of Documents described herein. THIS IS NOT A CHE OF PROCEED WITH THE WORK DESCRIBED IN THE POPIOR to commencing work.	ANGE ORDER, A
issued in accorda	nce with Contract Documents without c	cordance with the modifications to the Contract E change in Contract Sum or Contract Time. Proceed wledgement that there will be no change in the Co	ding with the Work in
written approval	* *	be performed on a "TIME AND MATERIALS" (T&M, cribed herein prior to commencing work.) basis. Contactor to receive
SUMMARY: DESCRIPTION:	TECH SERVICES 111 CASEWORK	AND CHILDREN'S HALF CIRCLE TABLES	
Please see attached	e pricing to include the following score revised drawing sheet SI 55.1 R1 and 5.1' and 'MP-501' respectively in the	d revised drawing sheet MP-501. These sheet	s shall replace the
General scope revision Revised countertop f	ons include: finishes and related sink revisions		
	-	R1) is now an undermount sink, the related on may allow for proper installation of the ow	
\$23,552,36			


CME is proposing a voluntary alternate to deduct \$859.71 from the PCO #62 to substitute the


same adjustable metal legs used in the A/V Office in lieu of the legs specified.


ATTACHMENTS: SI-55.1 R1, MP-501

ISSUED BY: Andrew Hesterman, Assoc. AIA, Associate

CC: MKM File, WCPL, CME, SCO

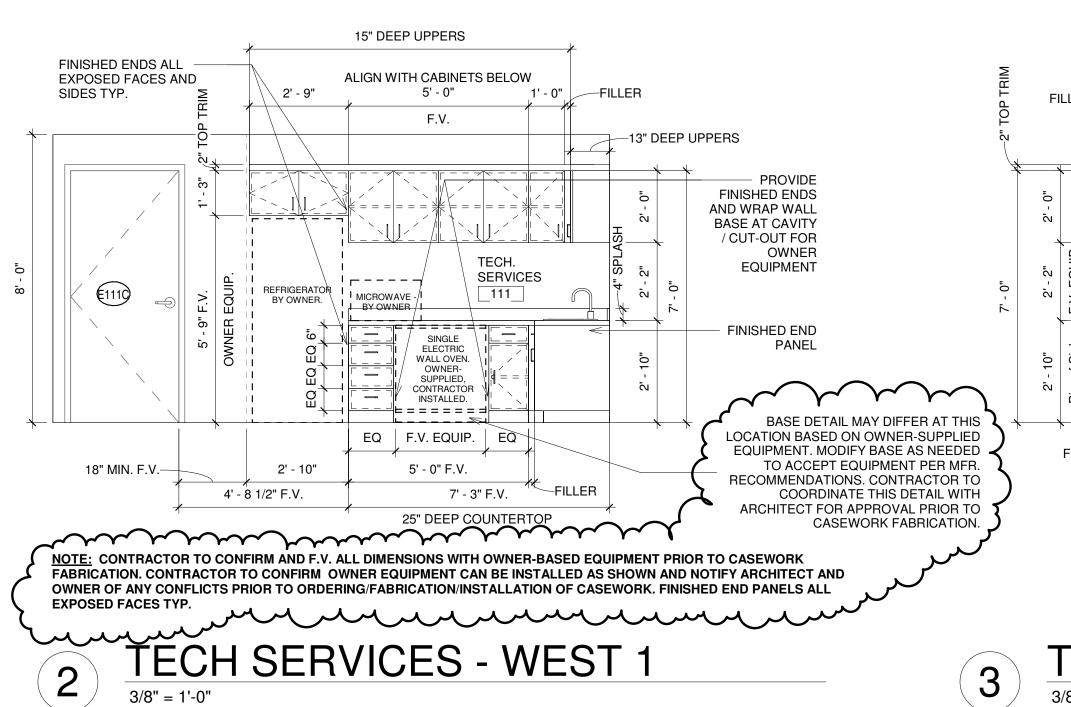

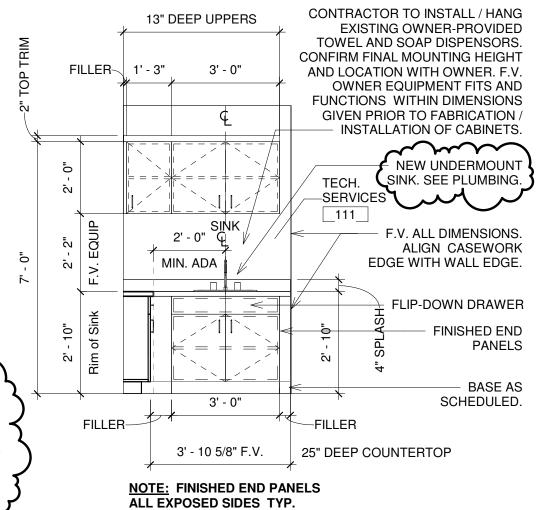

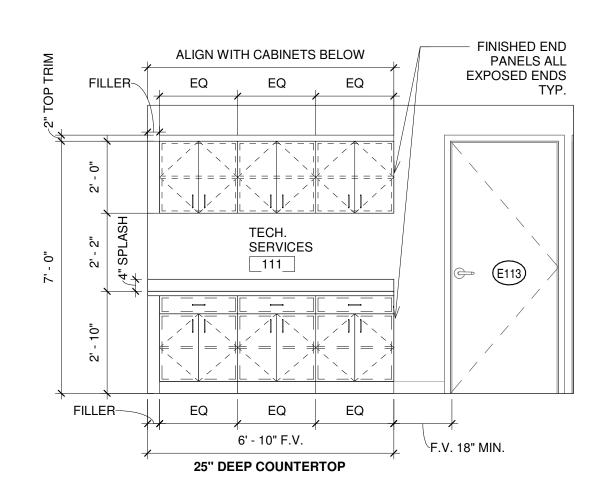

TECH SERVICES - NORTH

FINISHED ENDS ALL EXPOSED FACES AND 12' - 0" ALIGN WITH CABINETS BELOW SIDES TYP. FINISHED ENDS ALL EXPOSED FACES AND SIDES TYP. MAIL SLOTS -**FURNITURE** SERVICES BY-OWNER __111__ FINISHED ENDS ALL EXPOSED FACES AND SIDES TYP. 3' - 0" 3' - 0" 3' - 0" 3' - 0" 12' - 0" - 30" DEEP COUNTER FILLER (AS NEEDED) 3' - 0"

3/8" = 1'-0"

TECH SERVICES - SOUTH

CASEWORK NOTES FOR THIS SHEET / SCOPE OF WORK:

ALL UPPER CABINETS AND BASE CABINETS TO BE: ALL COUNTERTOPS TO BE:

L-4 - WILSONART SOLAR OAK 7816-60 S-2 - WILSONART KIMBERLITE WITH BEVEL EDGI

25" DEEP COUNTER

- CONTRACTOR TO REMOVE EXISTING CABINETS CAREFULLY AND OFFER TO OWNER PRIOR TO DISPOSAL AT WEST AND NORTH WALL CONDITION.
- CONTRACTOR TO PROVIDE PHOTOS AND WRITTEN DOCUMENTATION OF THE EXISTING ACP CEILING CONDITIONS UPON THE REMOVAL OF THE EXISTING UPPER CABINETS WHERE EXISTING UPPER CABINETS ABUT EXISTING CEILINGS. BEFORE FABRICATING OR INSTALLING ANY NEW CABINETS, CONFIRM WITH OWNER AND ARCHITECT TO DISCUSS THE NEED FOR ANY FURTHER SCOPE OF WORK RELATED TO CLEANING EXISTING CEILING TILES AND/OR REPLACING CERTAIN TILES WITH OWNER ATTIC STOCK CEILING TILES.
- CONTRACTOR TO PROVIDE IN-WALL BLOCKING AS NEEDED FOR NEW CABINET LOCATIONS.
- REFER TO SHEET A-421 FOR GENERAL CASEWORK NOTES, LEGEND, AND DETAILS





SIDE WALL

HEIGHT / CLEARANCE OF SIDE

APPROACH LAVATORIES & SINKS

ADA SIDE APPROACH

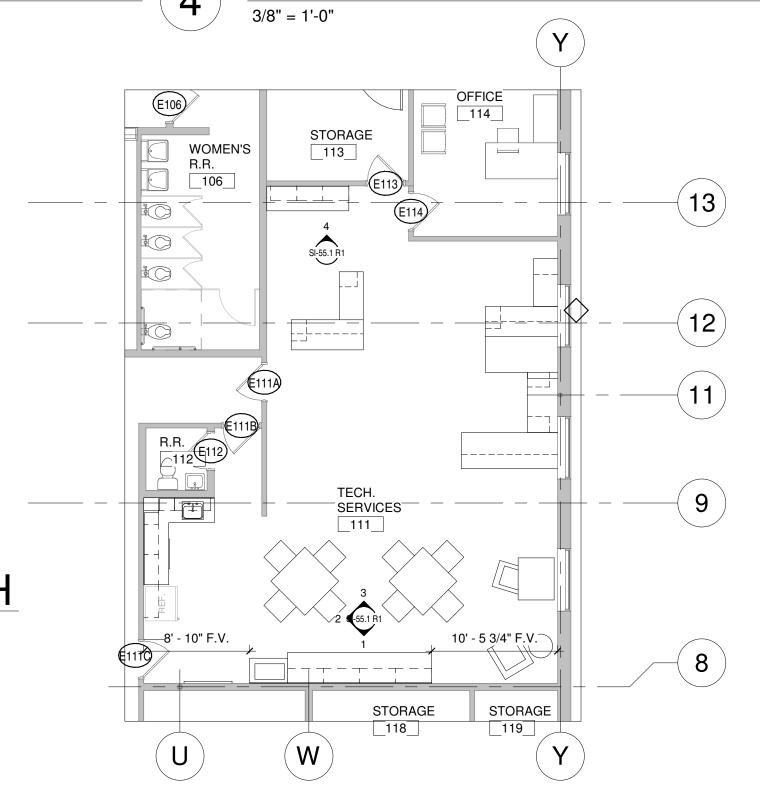

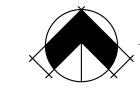

FIRST FLOOR NOTATION PLAN

119 WEST WAYNE **WELLS COUNTY** FORT WAYNE, IN 46802 PHONE: 260.422.0783 **PUBLIC LIBRARY** FAX: 260,426,4561 www.MKMdesign.con RENOVATION CONTACTS: <INSERT NAME> **SUPPLEMENTAL** <INSERT NAME> architecture + design | INFORMATION (SI) NO.

TECH SERV. CASEWORK PROJECT NO. 19067 SHEET NO. PROJECT DATE 10.10.2019 07/07/2020 SI-55.1 R² SHEET DATE SHEET REF. SCALEAs indicated

7/7/2020 5:57:11 PM

GENERAL CONDITIONS NOTE

ALL CONTRACTORS, BY MAKING THEIR BID, REPRESENT THAT THEY HAVE READ AND **UNDERSTAND** THE CONSTRUCTION DOCUMENTS. THE CONTRACTOR SHALL REFER TO THE ENTIRE CONSTRUCTION DOCUMENT SET FOR GUIDANCE ON DIMENSIONS, HEIGHTS, DETAILING, ETC. AND INSTALL THEIR WORK SO AS NOT TO INTERFERE WITH THE INSTALLATION OF ANOTHER DISCIPLINE'S WORK OR THE **GENERAL INTENT** OF THE CONSTRUCTION DOCUMENTS. IN THE EVENT OF A CONFLICT BETWEEN THE SPECIFICATIONS AND/ OR DRAWINGS, THE ARCHITECT SHALL DETERMINE WHICH INFORMATION GOVERNS.

M/P/E TRADES **NOTE**: IN REFERRING TO THIS SHEET YOU ACKNOWLEDGE: 1.) REVIEWING THE ENTIRE DRAWING SET INCLUDING ALL 'S', 'C' & 'A' SERIES. 2.) COORDINATING WITH THE GENERAL TRADES CONTRACTOR OR C.M. FOR EXACT DETAILING, HEIGHTS, ETC. PRIOR TO INSTALLING WORK.

IT IS THE INTENT OF THESE DRAWINGS AND THE SCOPE OF WORK FOR THIS PROJECT THAT ALL EXISTING DOMESTIC SUPPLY, SANITARY WASTE, AND SANITARY VENT PIPING THAT SERVES THE SECOND FLOOR AND IS MADE OBSOLETE BY THE SCOPE OF THIS PROJECT BE REMOVED COMPLETELY OR CAPPED IN A CONCEALED LOCATION. PATCH AND REPAIR ALL FLOOR, CEILING, AND WALL FINISHES THAT ARE TO REMAIN. IT IS THE INTENT THAT ALL EXISTING PLUMBING FIXTURES NOT SHOWN TO BE REMOVED SHALL REMAIN ACTIVE AND CONNECTED TO THE EXISTING PIPING. THE PLUMBING CONTRACTOR SHALL BE RESPONSIBLE TO PROVIDE AND INSTALL ALL ADDITIONAL PIPING, FITTINGS, INSULATION, AND SUPPORTS REQUIRED TO RECONNECT ANY EXISTING TO REMAIN PLUMBING FIXTURES TO THE EXISTING PIPING FOR A FULLY FUNCTIONAL SYSTEM.

THIS CONTRACTOR IS RESPONSIBLE FOR REMOVING AND REINSTALLING ANY EXISTING CEILING TILES AND GRID AFFECTED BY THIS WORK. REPLACE ANY TILES DAMAGED AS A RESULT OF THE ABOVE WORK. TILES SHALL MATCH SURROUNDING CONDITIONS.


PLUMBING DEMOLITION PLAN NOTES

> REMOVE EXISTING SANITARY VENT PIPING COMPLETE TO POINT INDICATED, INCLUDING ALL ASSOCIATED HANGERS AND SUPPORTS, AND MAKE READY FOR NEW WORK. 2> REMOVE EXISTING SINK COMPLETE INCLUDING FAUCET, AND ALL ACCESSORIES, ALL DOMESTIC COLD AND HOT WATER SUPPLY LINES FROM ANGLE STOPS, ANGLE STOP VALVES, MOUNTING HARDWARE, AND SANITARY WASTE PIPING BACK TO WALL PENETRATION AS REQUIRED. MAKE READY FOR INSTALLATION OF A NEW SINK IN THE SAME LOCATION. REFER TO ARCHITECTURAL DRAWINGS AND PLUMBING PLANS FOR ADDITIONAL INFORMATION.

> REMOVE EXISTING DOMESTIC COLD WATER PIPING, INCLUDING ALL ACCESSORIES AND HANGERS COMPLETE, TO POINT INDICATED AND MAKE READY FOR NEW WORK. 4 > REMOVE EXISTING FLOOR DRAIN AND BELOW SLAB SANITARY PIPING TO POINT INDICATED AND CAP PIPING. SAW CUT EXISTING FLOOR AS REQUIRED TO PERFORM WORK AND MAKE READY FOR NEW WORK. PIPING LOCATION SHOWN IS

APPROXIMATE, FIELD VERIFY ACTUAL LOCATION OF BELOW SLAB PIPING. PATCH FLOOR TO MATCH EXISTING. 5> REMOVE EXISTING QUARTER TURN BALL VALVE AND DOMESTIC WATER LINE TO BELOW SLAB AND CAP PIPING. SAW CUT EXISTING FLOOR AS REQUIRED TO PERFORM WORK AND MAKE READY FOR NEW WORK. PIPING LOCATION SHOWN IS APPROXIMATE, FIELD VERIFY ACTUAL LOCATION OF BELOW SLAB PIPING. PATCH FLOOR TO MATCH EXISTING. 6 > REMOVE EXISTING SANITARY PIPING TO BELOW SLAB AND CAP PIPING. SAW CUT EXISTING FLOOR AS REQUIRED TO PERFORM WORK AND MAKE READY FOR NEW WORK. PIPING LOCATION SHOWN IS APPROXIMATE, FIELD VERIFY ACTUAL LOCATION OF BELOW SLAB PIPING. PATCH FLOOR TO MATCH EXISTING.

> REMOVE EXISTING WALL CLEAN OUT AND SANITARY WASTE PIPING WITHIN WALL AS REQUIRED TO TIE INTO EXISTING PIPING FOR NEW WORK. PIPING LOCATION SHOWN IS APPROXIMATE, FIELD VERIFY ACTUAL LOCATION OF PIPING. PATCH WALL TO MATCH EXISTING.

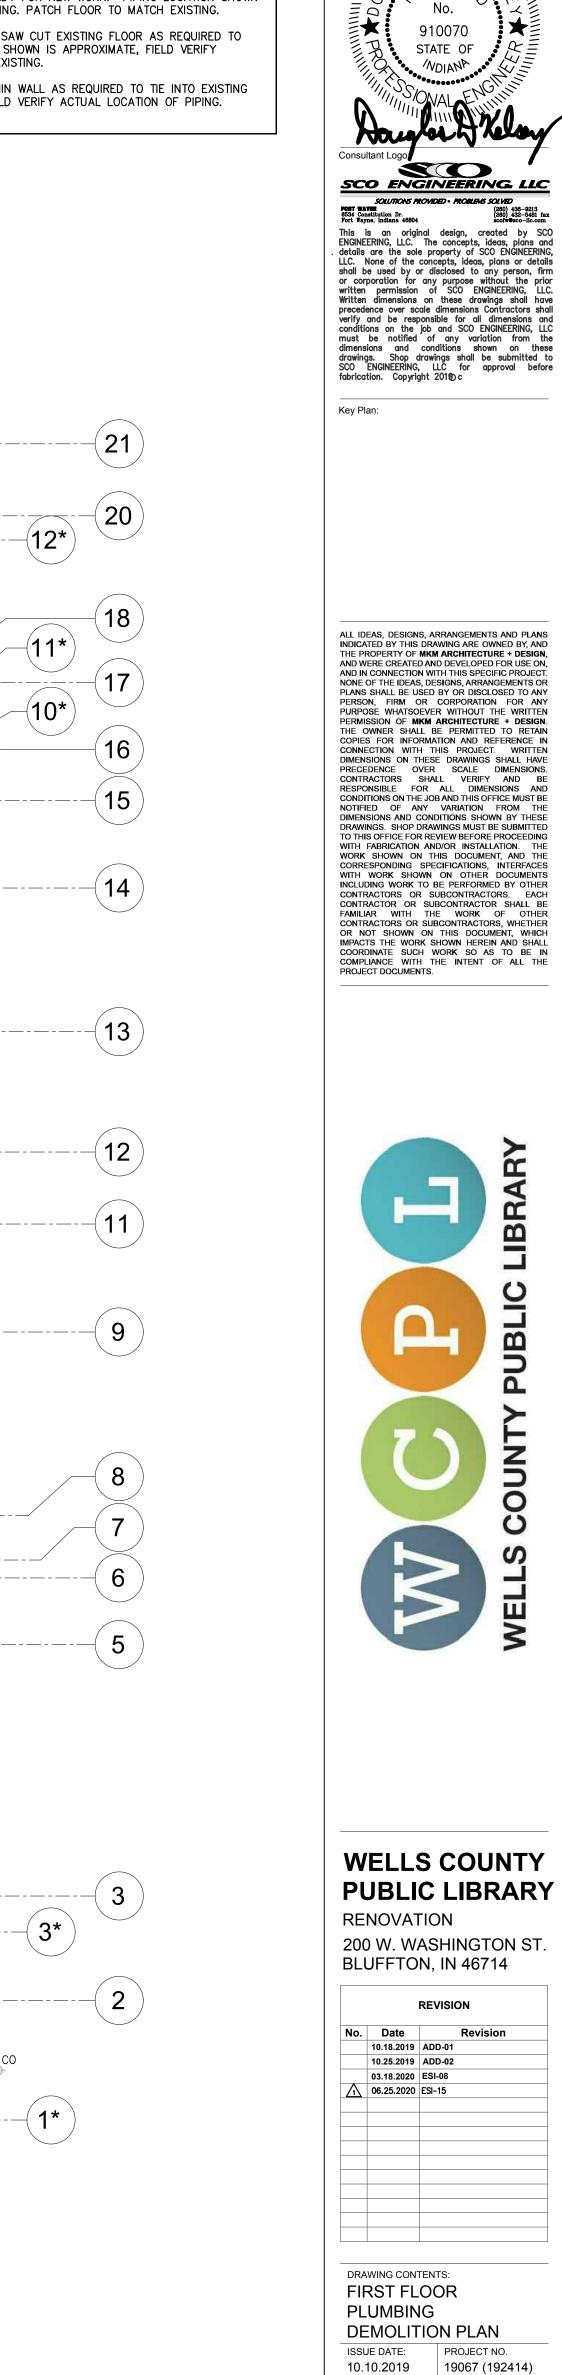

DRAWING NO.

P-011

architecture + design

910070

STATE OF


119 West Wayne Street

www.MKMdesign.com

p 260.422.0783

Certification: ,,,\\

Fort Wayne, Indiana 46802

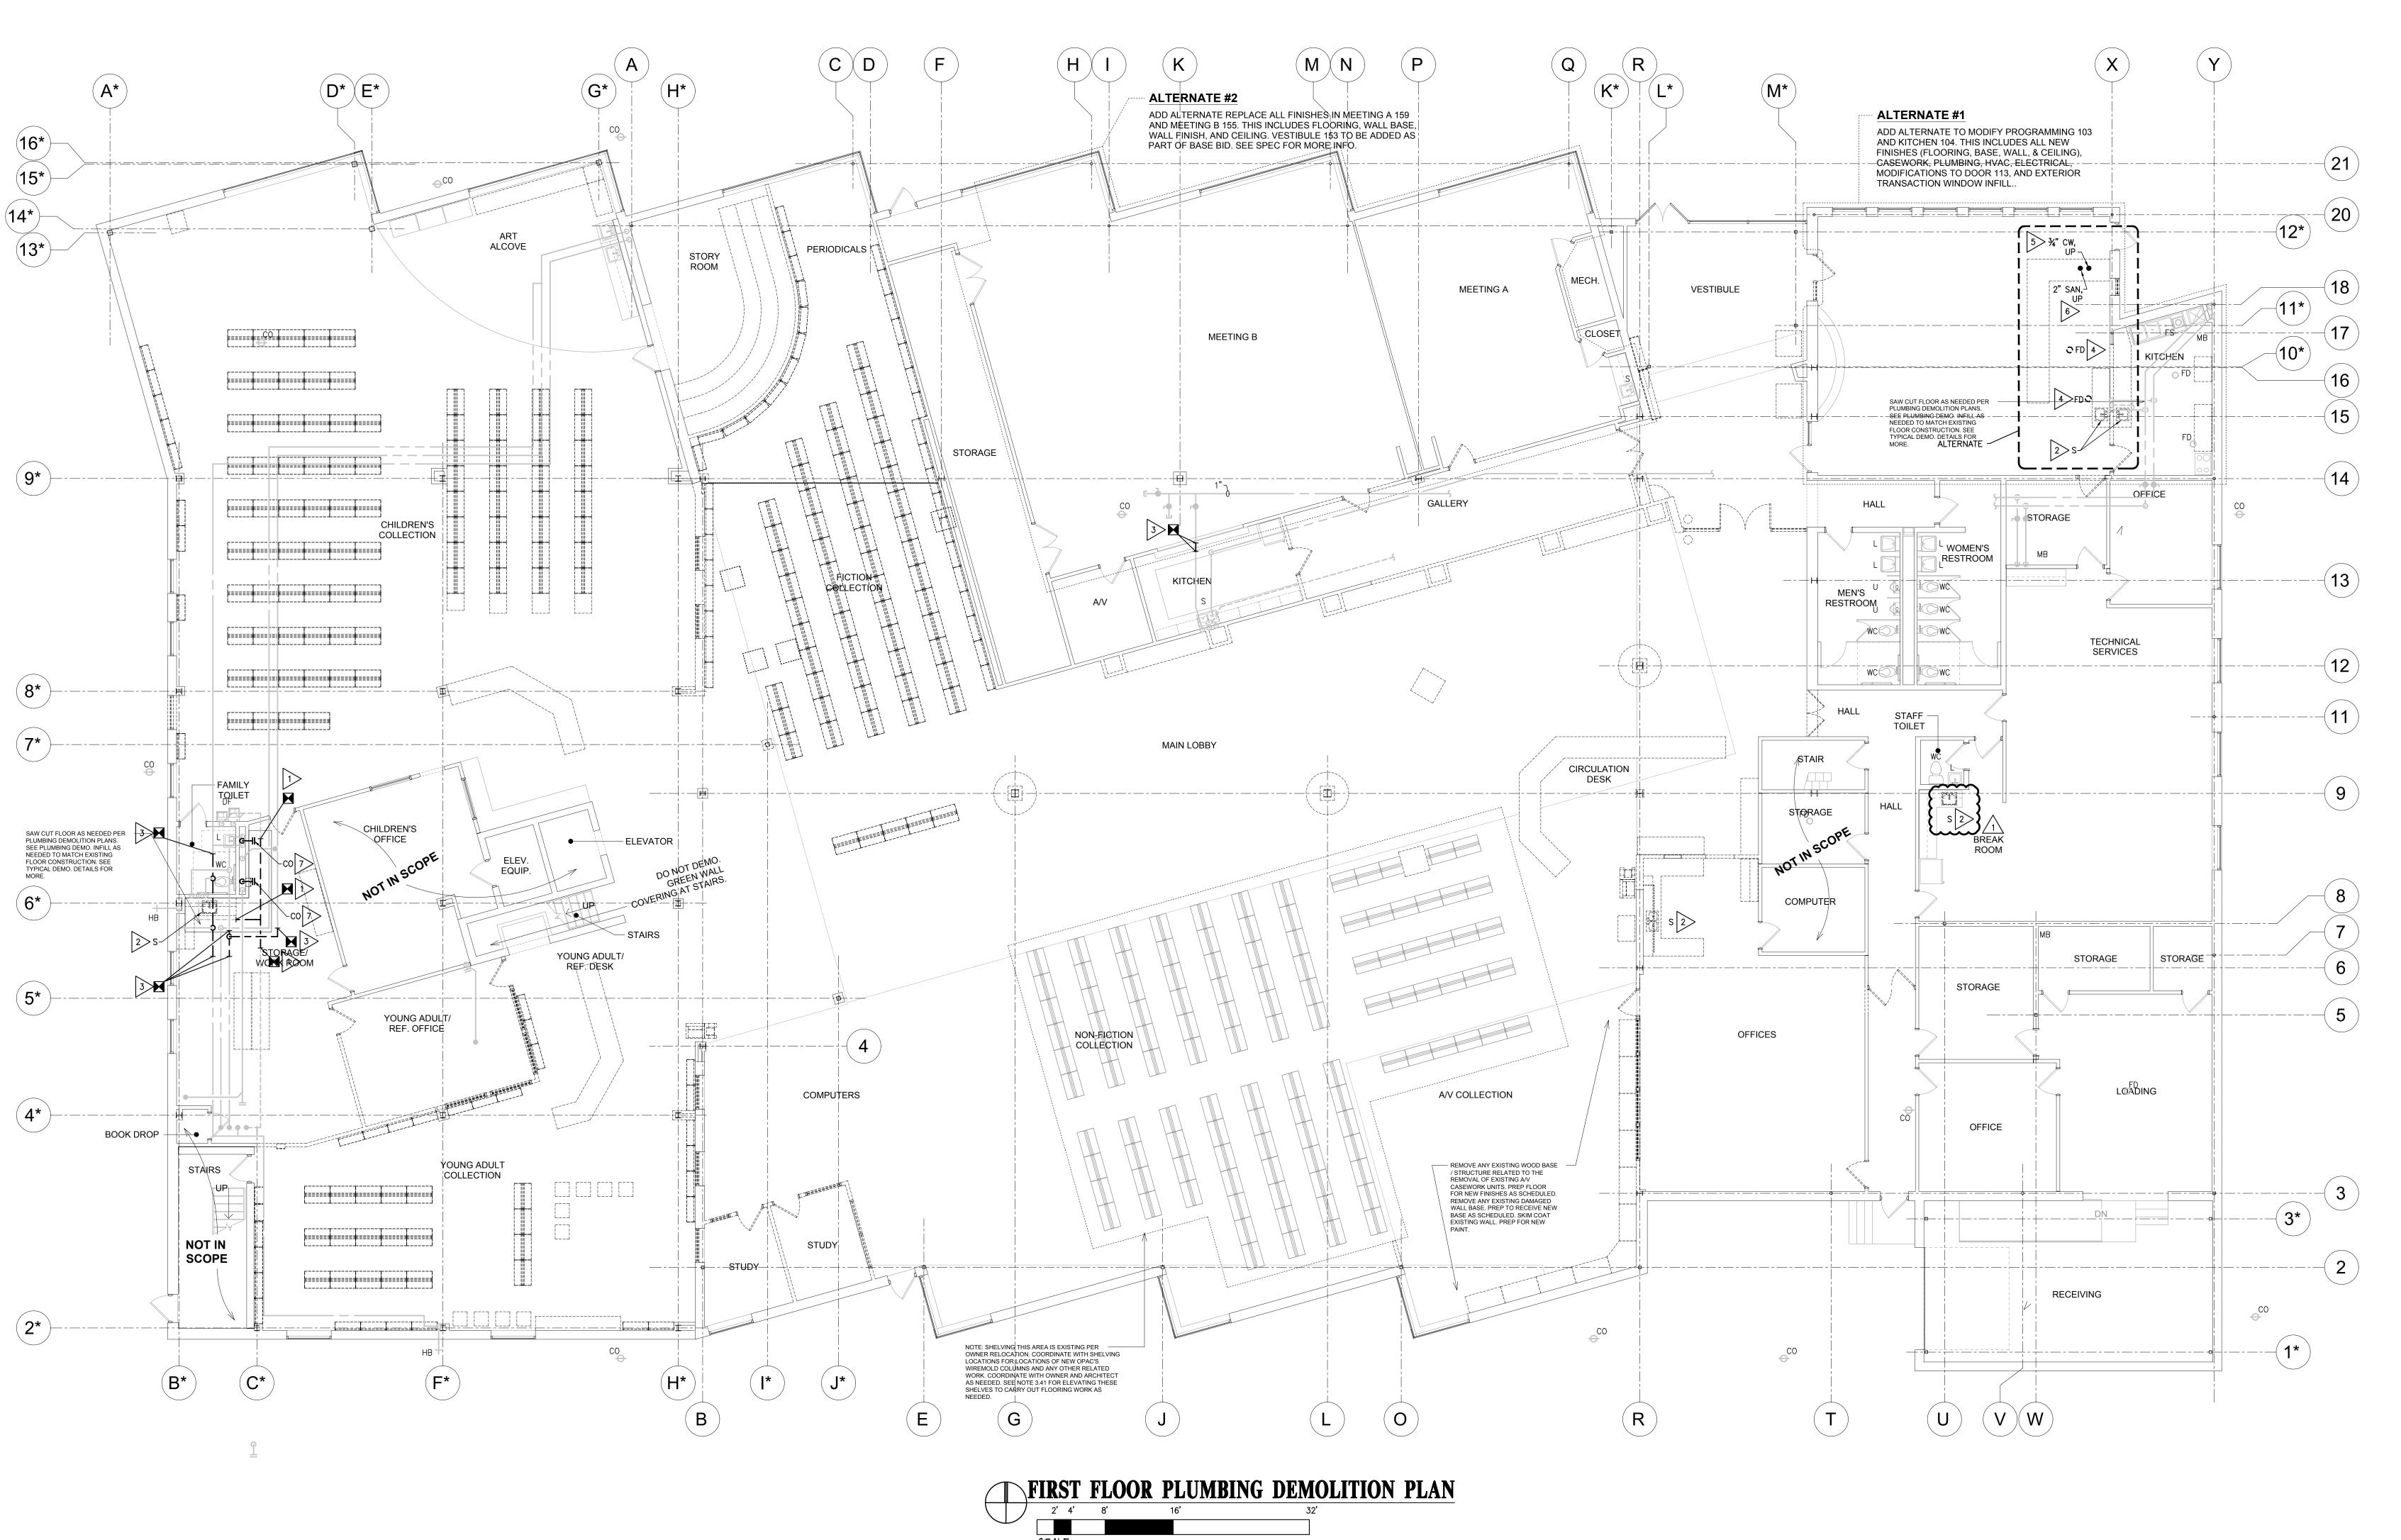

THE LOCATIONS OF EXISTING DOMESTIC WATER PIPING, SANITARY WASTE, AND STORM PIPING AS SHOWN ON THESE PLANS, ARE BASED UPON VISIBLY APPARENT ABOVE-GROUND STRUCTURES AND RECORD INFORMATION COLLECTED FOR THIS PROJECT. THE LOCATIONS OF THE PIPING MAY VARY FROM LOCATIONS SHOWN HEREON. THE ACTUAL LOCATION OF THE EXISTING UTILITIES ARE NOT CERTIFIED NOR GUARANTEED BY THE OFFICE OF THE ENGINEER. ALL LOCATIONS ARE APPROXIMATE AND SHOULD BE CONFIRMED IN THE FIELD.

THE PLUMBING CONTRACTOR SHALL BE RESPONSIBLE TO PROVIDE AND INSTALL ALL THROUGH PENETRATION FIRESTOP SYSTEMS AS REQUIRED TO SEAL WHERE PIPING PENETRATES A FIRE RATED WALL, FLOOR, OR OTHER LISTED ASSEMBLY. THE PLUMBING CONTRACTOR IS TO REVIEW LIFE SAFETY, AND ALL OTHER ARCHITECTURAL, DRAWINGS FOR THE EXACT LOCATION OF FIRE RATED ASSEMBLIES.

GENERAL CONDITIONS NOTE

ALL CONTRACTORS, BY MAKING THEIR BID, REPRESENT THAT THEY HAVE READ AND UNDERSTAND THE CONSTRUCTION DOCUMENTS. THE CONTRACTOR SHALL REFER TO THE ENTIRE CONSTRUCTION DOCUMENT SET FOR GUIDANCE ON DIMENSIONS, HEIGHTS, DETAILING, ETC. AND INSTALL THEIR WORK SO AS NOT TO INTERFERE WITH THE INSTALLATION OF ANOTHER DISCIPLINE'S WORK OR THE GENERAL INTENT OF THE CONSTRUCTION DOCUMENTS. IN THE EVENT OF A CONFLICT BETWEEN THE SPECIFICATIONS AND/ OR DRAWINGS, THE ARCHITECT SHALL DETERMINE WHICH INFORMATION GOVERNS.

M/P/E TRADES **NOTE**: IN REFERRING TO THIS SHEET YOU ACKNOWLEDGE: 1.) REVIEWING THE **ENTIRE** DRAWING SET INCLUDING ALL 'S', 'C' & 'A' SERIES. 2.) COORDINATING WITH THE GENERAL TRADES CONTRACTOR OR C.M. FOR EXACT DETAILING, HEIGHTS, ETC. PRIOR TO

PLUMBING PLAN NOTES


CONTRACTOR SHALL PROVIDE AND INSTALL A NEW WALL MOUNT LAV IN LOCATION AS SHOWN. CUT AND NOTCH WALL AS REQUIRED FOR INSTALLATION OF NEW FIXTURE. PROVIDE AND INSTALL STRUCTURAL BLOCKING WITHIN THE WALL CAVITY FOR MOUNTING OF THE WALL BRACKET. TIE-IN AND EXTEND EXISTING DOMESTIC HOT AND COLD WATER PIPING. SANITARY WASTE PIPING, AND SANITARY VENT PIPING WITHIN THE WALL AND ROUTE AS REQUIRED FOR CONNECTION TO NEW FIXTURE. STUB OUT HOT AND COLD WATER SUPPLIES AND PROVIDE AND INSTALL NEW ESCUTCHEONS, ANGLE STOPS, DOMESTIC WATER SUPPLIES, AND P-TRAP, AND CONNECT TO THE EXISTING PIPING LOCATED WITHIN THE WALL. MODIFY AND EXTEND THE EXISTING PIPING AS REQUIRED FOR THE INSTALLATION OF THE NEW FIXTURE. PATCH WALL

2) TIE-IN AND CONNECT NEW 2"Ø SANITARY WASTE VENT PIPING TO EXISTING PIPING AND ROUTE AS SHOWN. PROVIDE

- CONNECTIONS TO EACH FIXTURE. REFER TO PLUMBING FIXTURE SCHEDULE FOR FINAL CONNECTION SIZES. 3) TIE-IN AND CONNECT NEW 2" COLD WATER AND 1" HOT WATER PIPING TO EXISTING WATER PIPING AND ROUTE AS SHOWN. PLUMBING CONTRACTOR SHALL RECONNECT ALL EXISTING PIPING TO MAIN AS REQUIRED FOR A FULLY FUNCTIONING SYSTEM. PROVIDE AND INSTALL ALL NECESSARY OFFSETS AND TRANSITIONS IN PIPING AS REQUIRED.
- 4) 2" COLD WATER, ½" HOT WATER, AND 2" SANITARY VENT PIPING TO BE ROUTED DOWN WITHIN CHASE FOR CONNECTION TO EACH PLUMBING FIXTURE. REFER TO PLUMBING FIXTURE SCHEDULE FOR FINAL CONNECTION SIZES. 5) TIE-IN AND CONNECT NEW ½" COLD WATER PIPING TO EXISTING WATER PIPING AND ROUTE AS SHOWN. CUT AND

NOTCH WALL AS REQUIRED FOR INSTALLATION OF NEW WALL BOX. PIPING SHALL ROUTE DOWN WITHIN WALL FOR

- CONNECTION TO WALL BOX. PROVIDE AND INSTALL 1/4 TURN BALL VALVE AND MAKE READY FOR CONNECTION TO OWNER SUPPLIED EQUIPMENT. PATCH WALL TO MATCH EXISTING. (6) CONTRACTOR SHALL PROVIDE AND INSTALL NEW PLUMBING FIXTURE IN LOCATION AS SHOWN. CUT AND NOTCH WALL AS REQUIRED FOR INSTALLATION OF FIXTURE. PROVIDE AND INSTALL STRUCTURAL BLOCKING WITHIN THE WALL AS REQUIRED FOR MOUNTING NEW FIXTURE. TIE-IN AND EXTEND EXISTING DOMESTIC HOT AND COLD WATER PIPING, SANITARY WASTE PIPING, AND SANITARY VENT PIPING WITHIN THE WALL AND ROUTE AS REQUIRED FOR CONNECTION
- TO NEW FIXTURE. STUB OUT HOT AND COLD WATER SUPPLIES AND PROVIDE AND INSTALL NEW ESCUTCHEONS, ANGLE STOPS, DOMESTIC WATER SUPPLIES, AND P-TRAP, AND CONNECT TO THE EXISTING PIPING LOCATED WITHIN THE WALL. MODIFY AND EXTEND THE EXISTING PIPING AS REQUIRED FOR THE INSTALLATION OF THE NEW FIXTURE. PATCH WALL

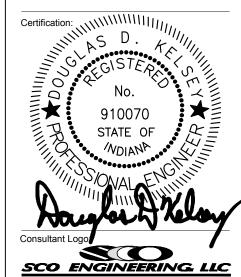

architecture + design

119 West Wayne Street

www.MKMdesign.com

p 260.422.0783

Fort Wayne, Indiana 46802

FORT WAYEE 6534 Constitution Dr. Fort Wayne, Indiana 46804 This is an original design, created by SCO ENGINEERING, LLC. The concepts, ideas, plans and details are the sole property of SCO ENGINEERING, LLC. None of the concepts, ideas, plans or details shall be used by or disclosed to any person, firm or corporation for any purpose without the prior written permission of SCO ENGINEERING, LLC. Written dimensions on these drawings shall have precedence over scale dimensions Contractors shall verify and be responsible for all dimensions and conditions on the job and SCO ENGINEERING, LLC must be notified of any variation from the dimensions and conditions shown on these drawings. Shop drawings shall be submitted to SCO ENGINEERING, LLC for approval before fabrication. Copyright 2018) c

Key Plan:

ALL IDEAS, DESIGNS, ARRANGEMENTS AND PLANS INDICATED BY THIS DRAWING ARE OWNED BY, AND THE PROPERTY OF MKM ARCHITECTURE + DESIGN, AND WERE CREATED AND DEVELOPED FOR USE ON, AND IN CONNECTION WITH THIS SPECIFIC PROJECT. NONE OF THE IDEAS, DESIGNS, ARRANGEMENTS OR PLANS SHALL BE USED BY OR DISCLOSED TO ANY PERSON, FIRM OR CORPORATION FOR ANY PURPOSE WHATSOEVER WITHOUT THE WRITTEN PORPOSE WHATSOEVER WITHOUT THE WRITTEN
PERMISSION OF MKM ARCHITECTURE + DESIGN.
THE OWNER SHALL BE PERMITTED TO RETAIN
COPIES FOR INFORMATION AND REFERENCE IN
CONNECTION WITH THIS PROJECT. WRITTEN CONNECTION WITH THIS PROJECT: WRITTEN
DIMENSIONS ON THESE DRAWINGS SHALL HAVE
PRECEDENCE OVER SCALE DIMENSIONS.
CONTRACTORS SHALL VERIFY AND BE
RESPONSIBLE FOR ALL DIMENSIONS AND
CONDITIONS ON THE JOB AND THIS OFFICE MUST BE
NOTIFIED OF ANY VARIATION FROM THE
DIMENSIONS AND CONDITIONS SHOWED BY THESE DIMENSIONS AND CONDITIONS SHOWN BY THESE DRAWINGS. SHOP DRAWINGS MUST BE SUBMITTED TO THIS OFFICE FOR REVIEW BEFORE PROCEEDING WITH FABRICATION AND/OR INSTALLATION. THE WORK SHOWN ON THIS DOCUMENT, AND THE CORRESPONDING SPECIFICATIONS, INTERFACES
WITH WORK SHOWN ON OTHER DOCUMENTS WITH WORK SHOWN ON OTHER DOCUMENTS INCLUDING WORK TO BE PERFORMED BY OTHER CONTRACTORS OR SUBCONTRACTORS. EACH CONTRACTOR OR SUBCONTRACTOR SHALL BE FAMILIAR WITH THE WORK OF OTHER CONTRACTORS OR SUBCONTRACTORS, WHETHER OR NOT SHOWN ON THIS DOCUMENT, WHICH IMPACTS THE WORK SHOWN HEREIN AND SHALL COORDINATE SUCH WORK SO AS TO BE IN COMPLIANCE WITH THE INTENT OF ALL THE PROJECT DOCUMENTS.




WELLS COUNTY PUBLIC LIBRARY RENOVATION 200 W. WASHINGTON ST.

BLUFFTON, IN 46714 10.18.2019 ADD-01 10.25.2019 ADD-02 03.18.2020 ESI-08 3 06.25.2020 ESI-15

DRAWING CONTENTS: FIRST FLOOR PLUMBING PLAN

ISSUE DATE: PROJECT NO. 10.10.2019 19067 (192414) DRAWING NO.

P-201

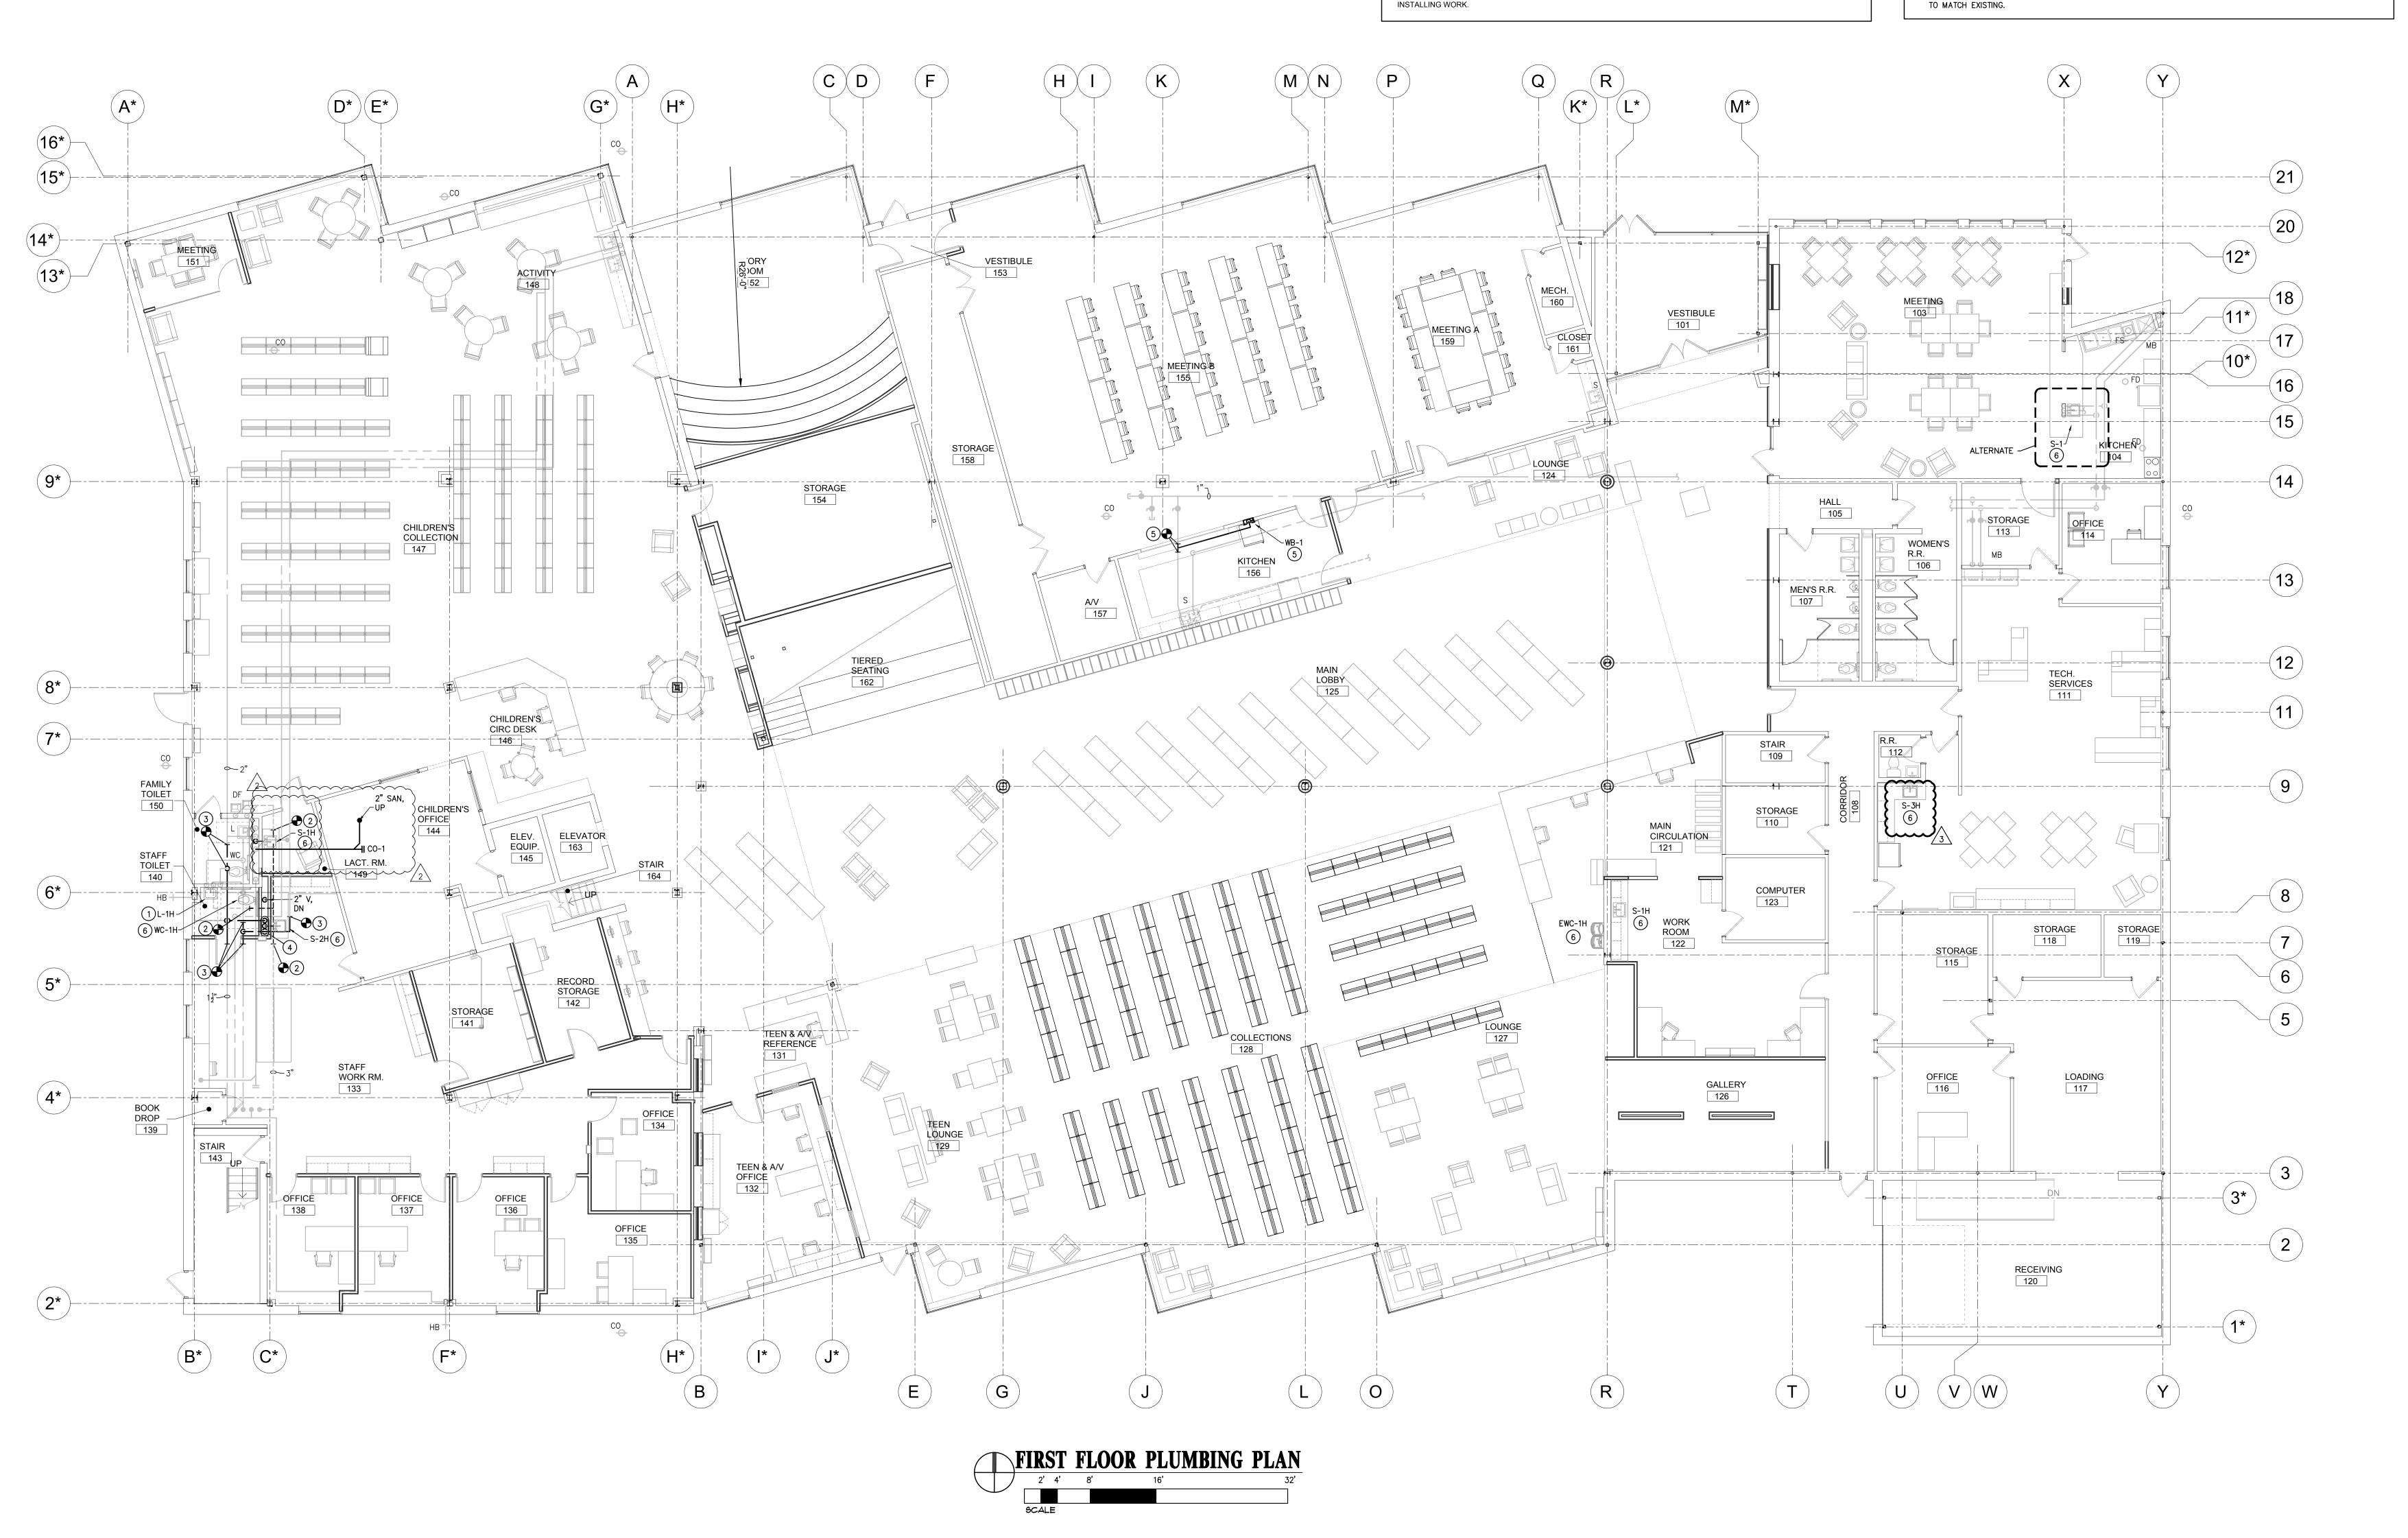

									DX	ROC	FTOF	UNIT S	3CHEE	DULE										
			AREA		AIR FL	OW (CFM)		SUPPLY FAN	BLOWER SECTION				DX COOLING					HEATING				FILTER MED	DIA	
TAG	MFG	MODEL	SERVED	SUPPLY	RETURN	OA MIN/MA	X ESP I	IP FAN TYPE	MODULATION	ELECT	MBH (TOT)	MBH (SEN)	EA DB/WB	AMBIENT	COMPRESSORS	INPUT MBH	OUTPUT MBH	EAT	MODULATION	FUEL E	FF (%)	TYPE	MERV	REMARK:
RTU-7	TRANE	YHC067	2ND FLOOR NON-FICTION	1800	1360	230 / 440	1.0	FC CENTRIFUGAI	_ VSD	460 / 3	56.8	41.7	78 / 65	105	VARIABLE	80	64	49	1 STAGE	NAT GAS	80	2" PLEATED	8	1 - 9
3. Pf 4. Pf 5. Pf 6. Pf 7. Pf	ROVIDE UNIT VEROVIDE UNIT VEROVIDE UNIT VEROVIDE WITH LEROVIDE UNIT VEROVIDE UNIT VEROVIDE UNIT VEROVIDE UNIT V	WITH 100% DRY WITH VARIABLE WITH FACTORY OW AMBIENT O WITH STAINLESS	REHEAT AND HUMIDISTAT FOR SPACE BULB ECONOMIZER WITH BARAMETRIC CAPACITY SCROLL COMPRESSORS AND INSTALLED CO2 SENSOR WIRING FOR I OOLING CAPACITY DOWN TO 0 DEGRE STEEL NATURAL GAS HEAT EXCHANC ATION INTERFACE TO THE BUILDING M	RELIEF.) VARIABI DEMAND (ES F. EER.	LE SPEED CONTROL V	SUPPLY FAN I ENTILATION AI	nd field ins	TALLED CO2 SENSOR.																

WC-1H KOHLER K-4325 SLOAN G2 8111-1.6 FLUSH VALVE 4" 2" 1" WHELD INTO THE PROPRET IN THE	1, 2 4, 5,	COLOR WHITE WHITE			T v			I I VIIVI		IIVIONE					
WC-1H KOHLER K-4325 SLOAN G2 8111-1.6 FLUSH VALVE 4" 2" 1" WHO L-1H KOHLER K-2005 CHICAGO 802-VE2805-317ABCP WRISTBLADE HANDLE 1 1/2" 1 1/2" 1/2" 1/2" WHO S-1 ELKAY ELUH191610 CHICAGO 786-LR9E35V317AB WRISTBLADE HANDLE 2" 1 1/2" 1/2" 1/2" STAIL S-1H ELKAY ELUH191610 CHICAGO 786-LR9E35V317AB WRISTBLADE HANDLE 2" 1 1/2" 1/2" STAIL S-2H FLKAY EACH ELUH191810 CHICAGO 786-LR9E35V317AB WRISTBLADE HANDLE 2" 1 1/2" 1/2" STAIL S-3H ELKAY ELUHAD211550 CHICAGO 786-LR9E35V317AB WRISTBLADE HANDLE 2" 1 1/2" 1/2" STAIL S-3H ELKAY ELUHAD211550 CHICAGO 786-LR9E35V317AB WRISTBLADE HANDLE 2" 1 1/2" 1/2" STAIL EWC-1H ELKAY LZSTL&WSVRLK	1, 2 4, 5,	WHITE	1"			ı w	I TYPE	MODEL	MFGR	I морец Г	MFGR	FIXTURE			
S-1 ELKAY ELUH191610 CHICAGO 786-LR9E35V317AB WRISTBLADE HANDLE 2" 1 1/2" 1/2" 1/2" STAII S-1H ELKAY ELUH191610 CHICAGO 786-LR9E35V317AB WRISTBLADE HANDLE 2" 1 1/2" 1/2" 1/2" STAII S-2H ELKAY EAQDUH3118 DELTA 9113-DST SINGLE LEVER HANDLE 2" 1 1/2" 1/2" STAII S-3H ELKAY ELUHAD211550 CHICAGO 786-LR9E35V317AB WRISTBLADE HANDLE 2" 1 1/2" 1/2" STAII EWC-1H ELKAY LZSTLBWSVRLK 1/2" STAII WB-1 GUY GREY BIM875 1/2" STAII WB-1 GUY GREY BIM875 1/2" STAII CO-1 JOSAM 55000-1-22 1/2" EPROPHENT STAII	SS 8	WHITE		!	2"	4"	FLUSH VALVE	G2 8111-1.6	SLOAN	K-4325	KOHLER	WC-1H			
S-1H ELKAY ELUH191610 CHICAGO 786-LR9E35V317AB WRISTBLADE HANDLE 2" 1 1/2" 1/2" STAII S-2H ELKAY EAQDUH3118 DELTA 9113-DST SINGLE LEVER HANDLE 2" 1 1/2" 1/2" STAII S-3H ELKAY ELUHAD211550 CHICAGO 786-LR9E35V317AB WRISTBLADE HANDLE 2" 1 1/2" 1/2" STAII EWC-1H ELKAY LZSTL8WSVRLK 1/2" STAII WB-1 GUY GREY BIM875 1/2" EPI CO-1 JOSAM 55000-1-22 1/2" EPI REMARKS:	SS 8		1/2"	1/2"	1 1/2"	1 1/2"	WRISTBLADE HANDLE	802-VE2805-317ABCP	CHICAGO	K-2005	KOHLER	L-1H			
S-2H ELKAY EAQDUH3118 DELTA 9113-DST SINGLE LEVER HANDLE 2" 1 1/2" 1/2" STAIL S-3H ELKAY ELUHAD211550 CHICAGO 786-LR9E35V317AB WRISTBLADE HANDLE 2" 1 1/2" 1/2" 1/2" STAIL EWC-1H ELKAY LZSTL8WSVRLK 1/2" STAIL WB-1 GUY GREY BIM875 1/2" EPI CO-1 JOSAM 55000-1-22 1/2" EPI REMARKS:	·cc 02	STAINLESS	1/2"	1/2"	1 1/2"	2"	WRISTBLADE HANDLE	786-LR9E35V317AB	CHICAGO	ELUH191610	ELKAY	S-1			
S-3H ELKAY ELUHAD211550 CHICAGO 786-LR9E35V317AB WRISTBLADE HANDLE 2" 1 1/2" 1/2" 1/2" STAIL EWC-1H ELKAY LZSTL8WSVRLK 1/2" STAIL WB-1 GUY GREY BIM875 1/2" EP- CO-1 JOSAM 55000-1-22 1/2" EP- REMARKS:	.33 0,	STAINLESS	1/2"	1/2"	1 1/2"	2"	WRISTBLADE HANDLE	786-LR9E35V317AB	CHICAGO	ELUH191610	ELKAY	S-1H			
S-3H ELKAY ELUHAD211550 CHICAGO 786-LR9E35V317AB WRISTBLADE HANDLE 2" 1 1/2" 1/2" 1/2" STAIL EWC-1H ELKAY LZSTL8WSVRLK 1/2" STAIL WB-1 GUY GREY BIM875 1/2" EPC-1 JOSAM 55000-1-22 1/2" EPC-1 REMARKS:	SS 8. 9.	_ STAINLESS _	_1/2"_	_1/2"_	1 1/2"	_ 2" _	_ SINGLE_LEVER_HANDLE	9113-DSI	DELTA	EAQDUH3118	ELKAY	S-2H			
WB-1 GUY GREY BIM875 1/2" EPI CO-1 JOSAM 55000-1-22		STAINLESS	1/2"	1/2"	1 1/2"	2"	WRISTBLADE HANDLE	~~~~~~~~~~~~~~~~~~~~~~~~~~~~~~~~~~~~~~~	~~~~~~~~~~~~~~~~~~~~~~~~~~~~~~~~~~~~~~~	ELUHAD211550	ELKAY	$\sim\sim\sim\sim$			
CO-1 JOSAM 55000-1-22	SS 11, 12,	STAINLESS	7/2"		T 174"	T 174"				LŹSTŁ8WSVRĹK	ELKAY	EWC-1H	\ T		
CO-1 JOSAM 55000-1-22		EPOXY											71		
REMARKS:	16										JOSAM	CO-1			
PROVIDE AND INSTALL UNIT WITH PIPE WRAP KIT EQUAL TO TRUBRO OR PLUMBEREX PRO. PROVIDE AND INSTALL WALL HANGER BRACKET FOR MOUNTING DIRECTLY TO WALL.	PROVIDE AND INSTALL WALL HANGER BRACKET FOR MOUNTING DIRECTLY TO WALL.												5 6		
MOUNT RIM AT 34" A.F.F. TO MEET ADA REQUIREMENTS. REFER TO ARCHITECTURAL DRAWINGS FOR ADDITIONAL MOUNTING HEIGHT REQUIREMENTS AND DIMENSIONS PRIOR TO INSTALLATION. 8 PROVIDE AND INSTALL UNDEMOUNT SINK WITH ELKAY LK-18 DRAIN. 17 GAUGE P-TRAP, AND ANGLE STOPS WITH LOOSE KEY HANDLES.		LATION.) INSTAL	PRIOR TO	NSIONS F	ND DIME	· · · · · · · · · · · · · · · · · · ·						7		
PROVIDE AND INSTALL UNDEMOUNT SINK WITH ELKAT LK-18 DRAIN, 17 GAUGE P-TRAP, AND ANGLE STOPS WITH LOUSE KET HANDLES. PROVIDE AND INSTALL WITH DECK MOUNTED FAUCET WITH SINGLE HANDLE AND PULL DOWN SPRAYER.							OUSE RET HANDLES.	•	•				o o		
							N.						10		
	SINK IS INTENDED TO BE ADA SIDE APPROACH. REFER TO ARCHITECTURAL DRAWINGS FOR ADDITIONAL INFORMATION.														
10 SINK IS INTENDED TO BE ADA SIDE APPROACH. REFER TO ARCHITECTURAL DRAWINGS FOR ADDITIONAL INFORMATION.	PROVIDE AND INSTALL 17 GAUGE P-TRAP AND ANGLE STOPS WITH LOOSE KEY HANDLES.														
10 SINK IS INTENDED TO BE ADA SIDE APPROACH. REFER TO ARCHITECTURAL DRAWINGS FOR ADDITIONAL INFORMATION.															
10 SINK IS INTENDED TO BE ADA SIDE APPROACH. REFER TO ARCHITECTURAL DRAWINGS FOR ADDITIONAL INFORMATION. 11 PROVIDE AND INSTALL 17 GAUGE P-TRAP AND ANGLE STOPS WITH LOOSE KEY HANDLES.															
SINK IS INTENDED TO BE ADA SIDE APPROACH. REFER TO ARCHITECTURAL DRAWINGS FOR ADDITIONAL INFORMATION. PROVIDE AND INSTALL 17 GAUGE P-TRAP AND ANGLE STOPS WITH LOOSE KEY HANDLES. MOUNT MAXIMUM OF 34" A.F.F. TO LOWER BUBBLER WITH A MINIMUM OF 27" CLEARANCE BELOW TO MEET A.D.A. REQUIREMENTS.					TION.	ISTALLA1	QUIRED BY MANUFACTURER FOR IN	AND MISCELLANEOUS PARTS REC	D ALL REQUIRED PANELS	G FRAME, COOLING UNIT, AN	PROVIDE UNIT WITH MOUNTIN	4 F	14		

TAG	MFG	MODEL	CFM	ESP	MOTOR HP	FAN RPM	SONES	ELECT	CONTROL	AREA SERVED	REMARKS
EF-3	GREENHECK	SQ-98-VG	330	0.75"	1/4	1565	11.3	115 / 1	SWITCH	KITCHEN 156	1, 2
	·										

	LOUVER SCHEDULE											
			SIZE	AIR FLOWNIN	I. FREE AREA (F	N2/AX PD	MAX VEL.					
ΓAG	MANUFACTURER	MODEL	(IN)	(CFM)		(IN)	(FPM)	FUNCTION	FRAME	FINISH	MATERIAL	REMARK
L-1	GREENHECK	EHH-501	71"X35"	4700	7.1	0.05	500	EXHAUST	FLANGED	KYNAR	ALUMINUM	1, 2, 3
L-1 REMARKS		EHH-501	71″X35″	4700	7.1	0.05	500	EXHAUST	FLANGED	KYNAR	ALUMINUI	M

LOUVER SHALL BE INSTALLED FLUSH WITH FACE OF EXTERIOR WALL WITHIN EXISTING OPENING. PROVIDE AND INSTALL CAULK, BACKER ROD, INSULATION AND NON-SHRINK GROUT AS REQUIRED TO PROVIDE A WEATHER TIGHT INSTALLATION.

architecture + design

119 West Wayne Street Fort Wayne, Indiana 46802

p 260.422.0783 www.MKMdesign.com

Certification:

Key Plan:

ALL IDEAS, DESIGNS, ARRANGEMENTS AND PLANS

ALL IDEAS, DESIGNS, ARRANGEMENTS AND FLANS
INDICATED BY THIS DRAWING ARE OWNED BY, AND
THE PROPERTY OF MKM ARCHITECTURE + DESIGN,
AND WERE CREATED AND DEVELOPED FOR USE ON,
AND IN CONNECTION WITH THIS SPECIFIC PROJECT.
NONE OF THE IDEAS, DESIGNS, ARRANGEMENTS OR

NONE OF THE IDEAS, DESIGNS, ARRANGEMENTS OR PLANS SHALL BE USED BY OR DISCLOSED TO ANY PERSON, FIRM OR CORPORATION FOR ANY PURPOSE WHATSOEVER WITHOUT THE WRITTEN PERMISSION OF MKM ARCHITECTURE + DESIGN. THE OWNER SHALL BE PERMITTED TO RETAIN COPIES FOR INFORMATION AND REFERENCE IN CONNECTION WITH THIS PROJECT. WRITTEN DIMENSIONS ON THESE DRAWINGS SHALL HAVE PRECEDENCE OVER SCALE DIMENSIONS. CONTRACTORS SHALL VERIFY AND BE RESPONSIBLE FOR ALL DIMENSIONS AND CONDITIONS ON THE JOB AND THIS OFFICE MUST BE NOTIFIED OF ANY VARIATION FROM THE DIMENSIONS AND CONDITIONS AND CONDITIONS SHOWN BY THESE DRAWINGS. SHOP DRAWINGS MUST BE SUBMITTED TO THIS OFFICE FOR REVIEW BEFORE PROCEEDING

DRAWINGS. SHOP DRAWINGS MUST BE SUBMITTED TO THIS OFFICE FOR REVIEW BEFORE PROCEEDING WITH FABRICATION AND/OR INSTALLATION. THE WORK SHOWN ON THIS DOCUMENT, AND THE CORRESPONDING SPECIFICATIONS, INTERFACES WITH WORK SHOWN ON OTHER DOCUMENTS INCLUDING WORK TO BE PERFORMED BY OTHER CONTRACTORS OR SUBCONTRACTORS. EACH CONTRACTOR OR SUBCONTRACTORS SHALL BE FAMILIAR WITH THE WORK OF OTHER CONTRACTORS OR SUBCONTRACTORS, WHETHER OR NOT SHOWN ON THIS DOCUMENT, WHICH IMPACTS THE WORK SHOWN HEREIN AND SHALL COORDINATE SUCH WORK SO AS TO BE IN COMPLIANCE WITH THE INTENT OF ALL THE PROJECT DOCUMENTS.



WELLS COUNTY PUBLIC LIBRARY

PUBLIC LIBRAR
RENOVATION
200 W. WASHINGTON S BLUFFTON, IN 46714

		REVISION
No.	Date	Revision
	10.18.2019	ADD-01
	10.25.2019	ADD-02
	03.18.2020	ESI-08
3	06.25.2020	ESI-15
	t	

DRAWING CONTENTS: MECHANICAL & PLUMBING DETAILS & SCHEDULES ISSUE DATE: PROJECT NO. 10.10.2019 19067 (192414)

DRAWING NO. MP-501

This is an original design, created by SCO ENGINEERING, LLC. The concepts, ideas, plans and details are the sole property of SCO ENGINEERING, LLC. None of the concepts, ideas, plans or details shall be used by or disclosed to any person, firm or corporation for any purpose without the prior written permission of SCO ENGINEERING, LLC. Written dimensions on these drawings shall have precedence over scale dimensions Contractors shall verify and be responsible for all dimensions and conditions on the job and SCO ENGINEERING, LLC must be notified of any variation from the dimensions and conditions shown on these drawings. Shop drawings shall be submitted to SCO ENGINEERING, LLC for approval before fabrication. Copyright 2018) c

					LOU	VER S	3CHED	ULE				
			SIZE	AIR FLOWII	. FREE AREA (FTDD)AX PD	MAX VEL.					
TAG	MANUFACTURER	MODEL	(IN)	(CFM)		(IN)	(FPM)	FUNCTION	FRAME	FINISH	MATERIAL	REMARKS
L-1	GREENHECK	EHH-501	71"X35"	4700	7.1	0.05	500	EXHAUST	FLANGED	KYNAR	ALUMINUM	1, 2, 3


3. CUSTOM COLOR AS SELECTED BY ARCHITECT FROM CUSTOM KYNAR FINISHES.

TAG	MFG	MODEL	NECK	FACE	PATT	MAX CFM	MAX PD (TOTAL)	MAX NC	THROW (FEET)	MATERIAL	RI
D-1	TITUS	TMR	8"	15"	ROUND	245	0.09	20	10	STEEL	+
D-1 D-2	TITUS	TMS	8"	24" x 24"	LOUVERED	260	0.09	20	19	STEEL	+
D-3	TITUS	TMS	10"	24" x 24"	LOUVERED	330	0.09	22	19	STEEL	-
D-4	TITUS	300RL	12" x 8"	14" x 10"	SIDEWALL	345	0.07	20	26	STEEL	1
D-5	TITUS	300RL	16" x 8"	18" x 10"	SIDEWALL	360	0.07	20	26	STEEL	1 1
D-6	TITUS	TBD-30	8"	48" x8"	0.75" WIDE, 4 SLOT	200	0.06	20	20	STEEL	1
D-7	TITUS	CT-480	6"	60" x8"	LINEAR BAR	975	0.07	20	-	ALUMINUM	4
D-8	TITUS	TMR	10"	18"	ROUND	380	0.09	20	12	STEEL	
D-9	TITUS	TBD-80	10"	48" x10"	1.5" WIDE, 4 SLOT	385	0.07	28	20	STEEL	1
RG-1	TITUS	50F	10" x 10"	12" x 12"	EGGCRATE	295	0.04	20	-	ALUMINUM	+-
RG-2	TITUS	50F	22" x 22"	24" x 24"	EGGCRATE	2200	0.07	20	-	ALUMINUM	
RG-3	TITUS	CT-480	6"	60" x8"	LINEAR BAR	975	0.07	20	-	ALUMINUM	4
EG-1	TITUS	50F	22" x 22"	24" x 24"	EGGCRATE	2200	0.07	20	-	ALUMINUM	+-
EG-2	TITUS	50F	10" x 10"	12" x 12"	EGGCRATE	440	0.07	20	-	ALUMINUM	$oxed{oxed}$
DRAWI 2. PROVID	INGS FOR ROOM DE AND INSTALL	I FINISHES. L DUCT TRANSITION	N FITTINGS A	AS REQUIRED	I INTO CEILING TYPES AN FOR CONNECTION TO DI R, OPERABLE FROM THE	DIFFUSERS AND	D GRILLES.	\RCHITECTU!	RAL		

5. PROVIDE AND INSTALL ALIGNMENT STRIPS AND ALL REQUIRED ACCESSORIES FOR END TO END INSTALLATION WHERE MULTIPLE DIFFUSERS ARE SHOWN.

 \triangle

6. CUSTOM COLOR TO BE SELECTED BY ARCHITECT FROM MANUFACTURERS FULL LINE OF COLORS.

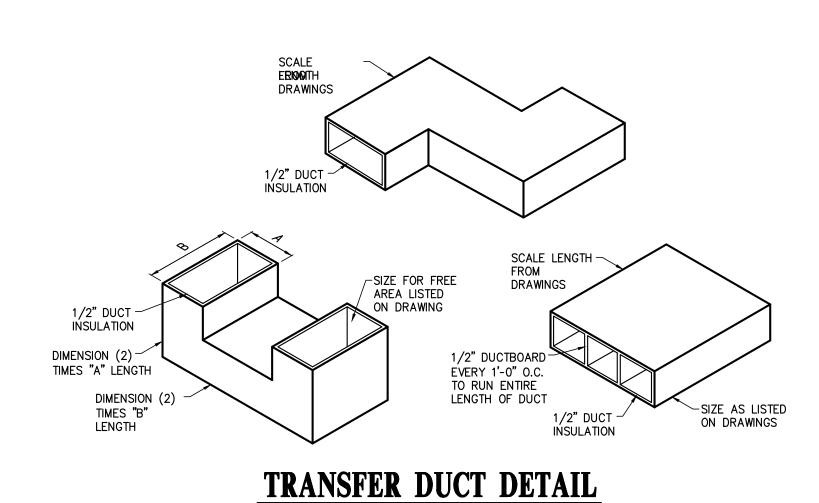

/ WINDOW

FIN TUBE RADIATOR ENCLOSURE DETAIL

NOT TO SCALE

24" HIGH -INSULATED CURB

ROOF DECK

SUPPLY // DUCT

NOT TO SCALE

CONTINUOUS

UNDER UNIT

ARCHITECTURAL ✓ ENCLOSURE

-3" UNFACED BATT

CAULK AROUND DUCT

RETURN DUCT

ROUTE UTILITIES TO UNIT INSIDE ROOF CURB. REFER

TO MFG. INSTALLATION

INSTRUCTIONS.

NOTE:
ROOFTOP UNIT AND SUPPORTS SHALL BE
DESIGNED TO WITHSTAND WIND LOAD AS PER IBC.

TYPICAL ROOF TOP UNIT DETAIL

PENETRATION, TYPICAL

INSULATION ON ROOF DECK UNDER UNIT

> \sim (2) 5/8" LAYERS OF MIĹDEW RESISTANT DRYWALL

FROM BUILDING

6" DIRT-LEG

┌ COCK


HVAC UNIT NATURAL GAS HOOK UP DETAIL

UNION - ✓ PRV -


NOT TO SCALE


EXISTING FIN TUBE HEATER

SEE PLANS FOR \sim DUCT SIZES MANUAL BALANCE DAMPER LEAVE HANDLE CLEAR FOR BALANCING, EXTEND BLADE SHAFT TO PREVENT EXTERNAL INSULATION DAMAGE FROM HANDLE FLEXIBLE DUCT. KEEP DUCT AS SHORT AS POSSIBLE. MAX. LENGTH 6 FT. MAY BE LOCATED IN VERTICAL DROP TO DIFFUSER DIFFUSER - SEE PLANS FOR TYPES AND SIZES. SUPPORT FROM CEILING GRIDWORK OR BUILDING STRUCTURE. RIGID METAL — ELBOW USE FOR CHANGES IN DIRECTION

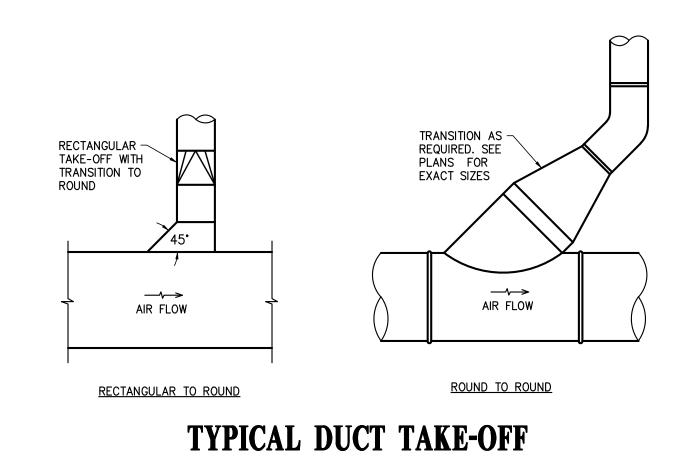

NOT TO SCALE

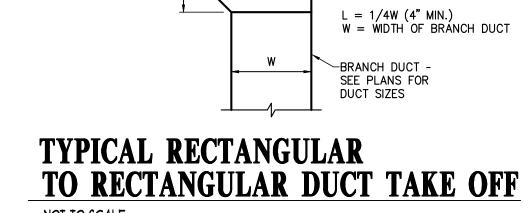

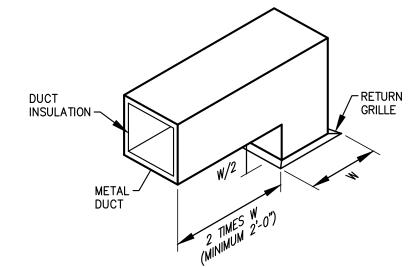

RETURN GRILLE DETAIL

NOT TO SCALE




_EQUIPMENT

/ CURB


TYPICAL RECTANGULAR
TO RECTANGULAR DUCT TAKE OFF NOT TO SCALE

MAIN DUCT -SEE PLANS FOR DUCT SIZES

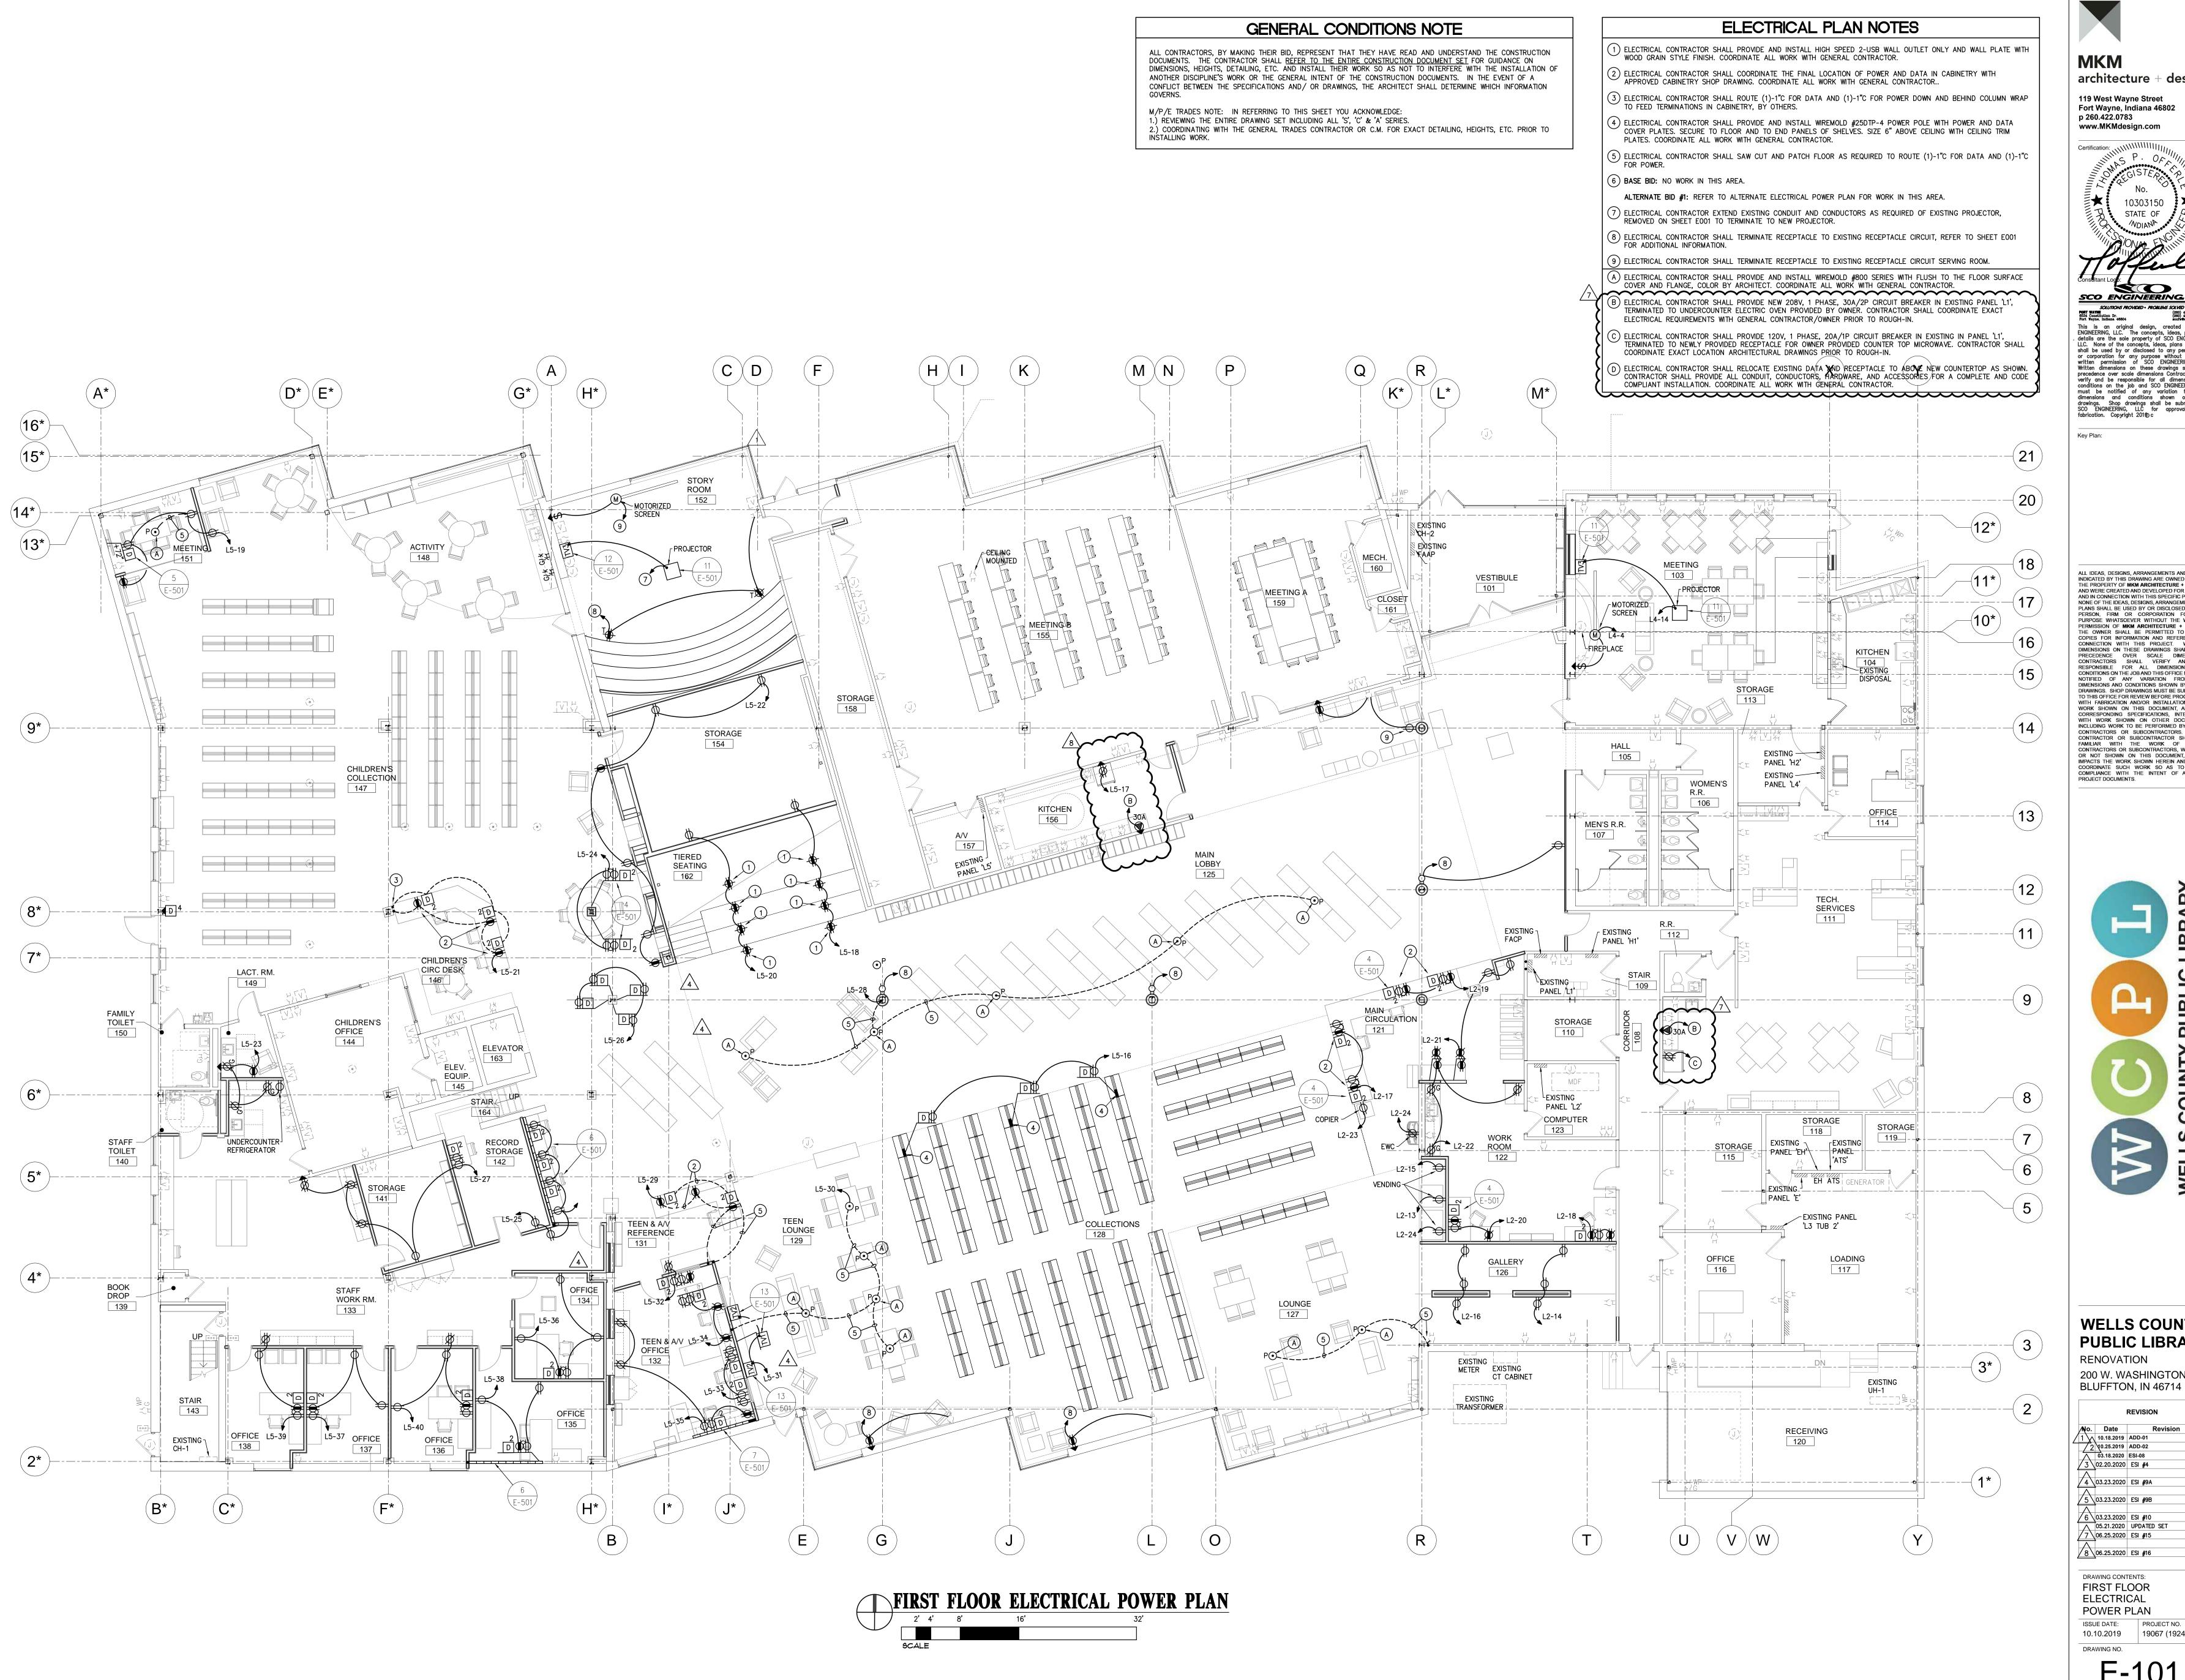

architecture + design

119 West Wayne Street Fort Wayne, Indiana 46802 p 260.422.0783 www.MKMdesign.com

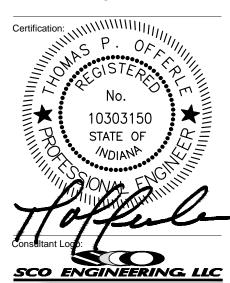

SOLUTIONS PROVIDED - PROBLEMS SOLVED

(280) 438-9213
(280) 432-5481 fax
sociw@soc-lic.com FORT WAYNE 6534 Constitution Dr. Fort Wayne, Indiana 46804 This is an original design, created by SCO ENGINEERING, LLC. The concepts, ideas, plans and details are the sole property of SCO ENGINEERING, LLC. None of the concepts, ideas, plans or details shall be used by or disclosed to any person, firm or corporation for any purpose without the prior written permission of SCO ENGINEERING, LLC. Written dimensions on these drawings shall have precedence over scale dimensions Contractors shall verify and be responsible for all dimensions and conditions on the job and SCO ENGINEERING, LLC must be notified of any variation from the dimensions and conditions shown on these drawings. Shop drawings shall be submitted to SCO ENGINEERING, LLC for approval before fabrication. Copyright 2019 c

Key Plan:

ALL IDEAS, DESIGNS, ARRANGEMENTS AND PLANS INDICATED BY THIS DRAWING ARE OWNED BY, AND THE PROPERTY OF MKM ARCHITECTURE + DESIGN, AND WERE CREATED AND DEVELOPED FOR USE ON, AND IN CONNECTION WITH THIS SPECIFIC PROJECT. NONE OF THE IDEAS, DESIGNS, ARRANGEMENTS OR PLANS SHALL BE USED BY OR DISCLOSED TO ANY PLANS SHALL BE USED BY OR DISCLOSED TO ANY PERSON, FIRM OR CORPORATION FOR ANY PURPOSE WHATSOEVER WITHOUT THE WRITTEN PERMISSION OF MKM ARCHITECTURE + DESIGN. THE OWNER SHALL BE PERMITTED TO RETAIN COPIES FOR INFORMATION AND REFERENCE IN COPIES FOR INFORMATION AND REFERENCE IN CONNECTION WITH THIS PROJECT. WRITTEN DIMENSIONS ON THESE DRAWINGS SHALL HAVE PRECEDENCE OVER SCALE DIMENSIONS. CONTRACTORS SHALL VERIFY AND BE RESPONSIBLE FOR ALL DIMENSIONS AND CONDITIONS ON THE JOB AND THIS OFFICE MUST BE NOTIFIED OF ANY VARIATION FROM THE DIMENSIONS AND CONDITIONS OF AND CONDITIONS SHOWED BY THESE DIMENSIONS AND CONDITIONS SHOWN BY THESE DRAWINGS. SHOP DRAWINGS MUST BE SUBMITTED TO THIS OFFICE FOR REVIEW BEFORE PROCEEDING WORK SHOWN ON THIS DOCUMENT, AND THE CORRESPONDING SPECIFICATIONS, INTERFACES WITH WORK SHOWN ON OTHER DOCUMENTS INCLUDING WORK TO BE PERFORMED BY OTHER CONTRACTORS OR SUBCONTRACTORS. EACH CONTRACTOR OR SUBCONTRACTOR SHALL BE FAMILIAR WITH THE WORK OF OTHER CONTRACTORS OR SUBCONTRACTORS, WHETHER OR NOT SHOWN ON THIS DOCUMENT, WHICH IMPACTS THE WORK SHOWN HEREIN AND SHALL COORDINATE SUCH WORK SO AS TO BE IN COMPLIANCE WITH THE INTENT OF ALL THE PROJECT DOCUMENTS.



WELLS COUNTY PUBLIC LIBRARY RENOVATION 200 W. WASHINGTON ST.

		REVISION
Νo.	Date	Revision
1 📐	10.18.2019	ADD-01
$\sqrt{2}$	10.25.2019	ADD-02
Δ	03.18.2020	ESI-08
/3\	02.20.2020	ESI #4
Δ		
/4\	03.23.2020	ESI #9A
Δ		
<u>/</u> 5\	03.23.2020	ESI #9B
Δ		
<u>/6</u> \	03.23.2020	ESI #10
Δ	05.21.2020	UPDATED SET
<u>/</u> 7\	06.25.2020	ESI #15
Δ		
/8\	06.25.2020	ESI #16

DRAWING CONTENTS: FIRST FLOOR ELECTRICAL POWER PLAN ISSUE DATE: PROJECT NO. 10.10.2019 19067 (192414) DRAWING NO.

E-101

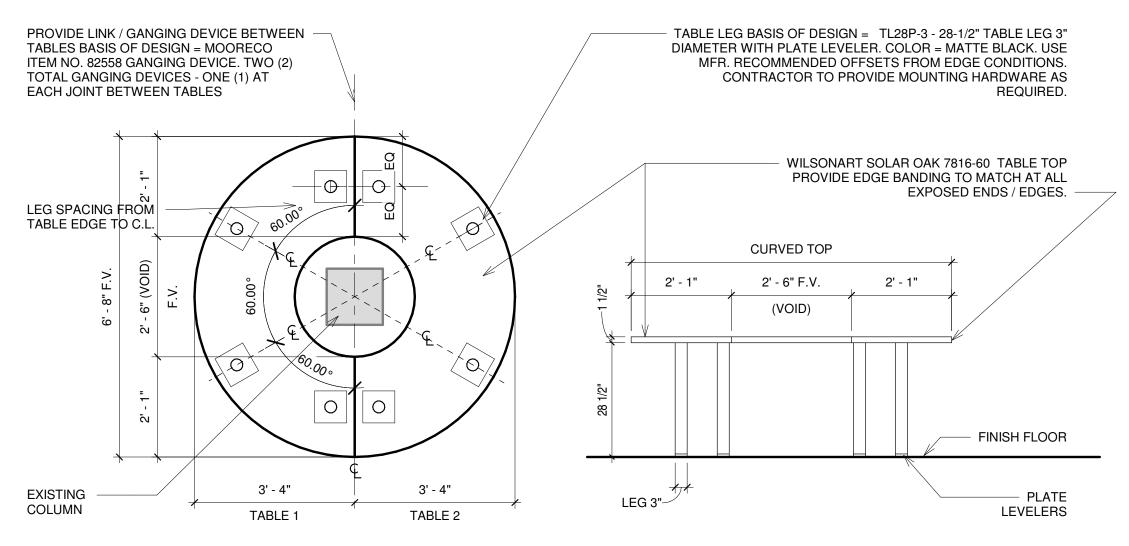


TABLE PLAN


TABLE ELEVATION (FROM INSIDE)

NOTE: FIELD-VERIFY EXISTING FINISH COLUMN DIMENSIONS PRIOR TO FABRICATION TO ENSURE TABLE DIMENSIONS DO NOT INTERFERE OR CONFLICT WITH EXISTING FINISH COLUMN LOCATION.



HALF CIRCLE TABLES

1/2" = 1'-0"

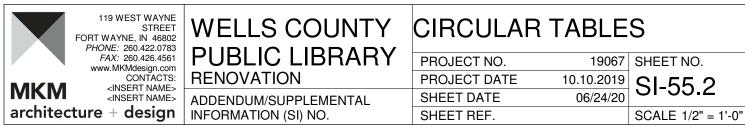

6/24/2020 5:16:58 PM



CME Corporation 7235 Vicksburg Pike Fort Wayne, 46804 Phone: (260) 745-0251 Project: 19218 - Wells County Public Library Interior Renovation 200 W Washington St Bluffton, Indiana 46714

Prime Contract Potential Change Order #062: SI-55.1 - Tech Services Casework and Half Circle Tables

ТО:	Wells County Public Library 200 W Washington Street Bluffton Indiana, 46714	FROM:	CME Corporation 7235 Vicksburg Pike Fort Wayne Indiana, 46804
PCO NUMBER/REVISION:	062 / 0	CONTRACT:	1 - Wells County Public Library Interior Renovation
REQUEST RECEIVED FROM:	Andrew Hesterman (MKM architecture + design)	CREATED BY:	Sean Hayes (CME Corporation)
STATUS:	Pending - In Review	CREATED DATE:	7/13 /2020
REFERENCE:		PRIME CONTRACT CHANGE ORDER:	None
FIELD CHANGE:	Yes		
LOCATION:	111 Tech Services	ACCOUNTING METHOD:	Amount Based
SCHEDULE IMPACT:	0 days	PAID IN FULL:	No
		TOTAL AMOUNT:	\$23,552.36

POTENTIAL CHANGE ORDER TITLE: SI-55.1 - Tech Services Casework and Half Circle Tables

CHANGE REASON: Client Request

POTENTIAL CHANGE ORDER DESCRIPTION: (The Contract Is Changed As Follows)

CE #126 - SI-55.1 - Tech Services Casework and Half Circle Tables See attached SI-55.1 - Tech Services Casework and Half Circle Tables.

- Includes removal/reinstallation of existing undermount cabinet lights.
- · Excludes replacement of existing ceiling above wall cabinets. Wall cabinets will be raised to ceiling.
- · Casework lead time 2-3 weeks from approval.
- Casework to be fabricated from SI-55.1 drawings and oven product data and excludes additional shop drawings. No shop drawings will be provided.

Voluntary Alternate:

 CME is proposing a voluntary alternate to deduct \$859.71 from the PCO #062 to substitute the same adjustable metal legs used in the A/V Office in lieu of the legs specified.

ATTACHMENTS:

PMC SI-55.1.pdf WMTC - SI-55.1.pdf INM - SI-55.1.pdf C&P SI 55.1 w- SS-2.pdf SI-55.1 - Tech Serv Casework - Countertop and Sink Revisions.pdf

#	Cost Code	Description	Туре	Amount
1	12-12300 - Casework/Blocking/Casework Joint Sealants	C&P - SI-55.1	Materials	\$ 9,505.00
2		CME - OH&P 10% on supplier		\$ 950.50
3	15-15400 - Plumbing	PMC - SI-55.1	Commitment	\$ 1,388.00





4		CME - OH&P 5% on PMC		\$ 69.40
5	16-16050 - Basic Electrical Materials	INM - SI-55.1 Commitment		\$ 2,570.00
6		CME - OH&P 5% on INM		\$ 128.50
7	09-09650 - Resilient Flooring	WMTC-SI-55	Commitment	\$ 221.70
8	09-09500 - Framing/Ceilings/Tectum	ectum CME - CME - OH&P 5% on WM Commitment		\$ 11.09
9		CME - Labor		\$ 4,492.10
10		CME - Materials		\$ 1,450.00
11		CME - Equipment		\$ 200.00
12	01-01715 - Waste Disposal	CME - Other	Other	\$ 590.00
13	01-01011 - Project Superintendant	CME - Supervision	Labor	\$ 868.00
14		CME - OH&P 10% on self-performed work		\$ 760.01
15	01-01910 - P & P Bond	CME - Bond 1.5%	Other	\$ 348.06
			Subtotal:	\$23,552.36
			Grand Total:	\$23,552.36

	Rejected: Proceed per Original Contract			
	Approved to Proceed with Work: Change	Proceed with Work: Change Order Forthcoming		
	Approved to Proceed with Work: Use Owner Contingency			
	Other:			
By:	Date:			

C & P Woodworking INC.

7108 CR # 17 Auburn, IN. 46706

260-637-3088 fax 260-637-8864

July 7, 2020 To CME Attention Sean From Carter RE: WCPL SI-55.2 REVISED

1 - Circular table with 8 legs, ganging hardware included.

Total \$ 1,955.00

Plastic laminate casework with solid surface counters counters, elevations 1 – 4

Total \$ 7,550.00

We can substitute the metal legs for our stock legs finished in anodized aluminum. These are typical to what was supplied in the work room. (Cost of legs is \$1,450.00)

Deduct -\$ 770.00

Thank you for your consideration, CP.

Precision Mechanical Contractors, inc.

• MBE CERTIFIED ~ DBE CERTIFIED ~ 8A CERTIFIED •

Quote

CME Corporation 7235 Vicksburg Pike Fort Wayne, IN 46804

JULY 13, 2020 Bid 2439

Ref: WCPL CE 123 - SI 55 Tech Services

PRECISION MECHANICAL IS PLEASED TO PROVIDE A QUOTATION FOR THE ABOVE PROJECT. OUR SCOPE OF WORK SHALL INCLUDE:

Plumbing

- Furnish and install new sink
- Connect to existing Plumbing

Base \$1,388.00

Material \$918.00 Labor \$470.00

Exclusions

- o Premium time
- Fire Suppression, Electrical, Painting, HVAC including gas
- o All floor, wall, roof cutting and patching by others
- o All utilites brought to building by others
- o Any repairs to existing systems or equipment
- Cleaning of Sanitary

Note: All work not spelled out in our scope is to be excluded and not assumed

We are pleased to submit the above quotation for your consideration. Should you have any questions, please call.

Sincerely,

Precision Mechanical Contractors, Inc.

Nelson Jordan President

4021 Clubview Drive • Fort Wayne, Indiana 46804

PH: 260-482-4600 • FAX: 260-482-4669 • E-mail: njordan@precisionmechanical.com

Request for Quote #012: CE #126 - SI-55.1 - Tech Services Casework and Half Circle Tables

General Related Items (0) Emails (0) Change History (5)

GENERAL INFORMATION

Number:	012	Date Created:	07/08/20 at 08:34 am
Created By:	Sean Hayes	Status:	Under Review
Title:	CE #126 - SI-55.1 - Tech Services Casework and Half Circle Tables	Change Event:	CE#126
Intent to quote:	Yes		
Due Date:	07/15/20		
Assignee:	Kline, Jeff (Weiffenbach Marble & Tile Co)	Distribution:	
Scope Description:	CME-SI-55.1		
Request Details:	CE #126 - SI-55.1 - Tech Services Casework and Half Circle Tables See attached SI-55.1 - Tech Services Casework and Half Circle Tables SI-13 already includes new flooring & rubber base for Tech Services. Confirm and report costs if any additional rubber base is needed on casework that would not have been accounted for on wall. I.E. sides of casework where noted.		
Attachments:	%SI-55.1 - Tech Serv Casework - Countertop and Sink Revisions.pdf		

RESPONSES

Date	Response By	Quote Amount	Schedule Impact	Comments	Attachments/Details
07/13/20 at 09:44 am	Sean Hayes	\$221.70	0 days	Add rubber base at toe kicks in room 111: Add \$221.70	

Request for Quote #029: CE #126 - SI-55.1 - Tech Services Casework and Half Circle Tables

General Related Items (0) Emails (0) Change History (7)

GENERAL INFORMATION

Number:	029	Date Created:	07/13/20 at 08:27 am
Created By:	Sean Hayes	Status:	Under Review
Title:	CE #126 - SI-55.1 - Tech Services Casework and Half Circle Tables	Change Event:	CE #126
Intent to quote:	Yes		
Due Date:	07/13/20		
Assignee:	Augspurger, Paul (INM Electric)	Distribution:	
Scope Description:	INM - SI-55.1		
Request Details:	CE #126 - SI-55.1 - Tech Services Casework and Half Circle Tables See attached SI-55 - Tech Services Casework and Half Circle Tables		

Attachments:

§SI-55.1 - Tech Serv Casework - Countertop and Sink Revisions.pdf

RESPONSES

Date	Response By	Quote Amount	Schedule Impact	Comments	Attachments/Details
07/13/20 at 10:15 am	Sean Hayes	\$2,570.00	0 days	Includes removal/reinstallation of the existing under cabinet lights in Tech Services.	
07/13/20 at 10:38 am	Sean Hayes				
07/13/20 at 10:40 am	Sean Hayes	\$2,570.00		Material \$890 Labor \$1,680 Total \$2,570	